

SUNFLOWER

MISSISSIPPI DEPARTMENT OF NATURAL RESOURCES  
Bureau of Land and Water Resources  
Southport Mall  
P.O. Box 10631  
Jackson, Mississippi 39209  
WATER WELL DRILLERS LOG

CODED

C-44  
4-30-80

#1

4-30 1980 date well completed  
Larry's Well + Pump firm name  
Sunflower county well located

LANDOWNER: Williamson, Orlis

description of formations encountered from to

Drew, Ms (mailing address)

Clay 0' 24'  
med. sand 24' 35'  
coarse sand 35' 60'  
coarse sand + sm gravel 60' 110'

WELL LOCATION:  
sec. 33 T-23 N R-4 E  
4 miles W of Drew  
(distance) (direction) (nearest town)

WELL PURPOSE: irrigation  
(home, irrigation, municipal, industrial)

WELL COMPLETION DATA:  
(1) diameter (inches) 8"  
(2) total depth (feet) 110'  
(3) static water level (feet) 29' below top of ground.  
(4) casing plastic 70' (material) (depth)  
(size) if telescope see back.  
(5) screen 40' 70' (length) (depth to top)  
8" plastic (size) (material)  
(6) pump 7/2 500 (HP) (yield gpm)  
electric (type power)  
(7) electric log No (yes or no)  
(organization running log)

(8) how well bottom plugged  
plastic cap

DRILLERS REMARKS:


CODED

MISSISSIPPI DEPARTMENT OF NATURAL RESOURCES  
BUREAU OF LAND & WATER RESOURCES  
JUN 30 1980

RECEIVED

If well telescopes please sketch and show depths.

GROUND LEVEL

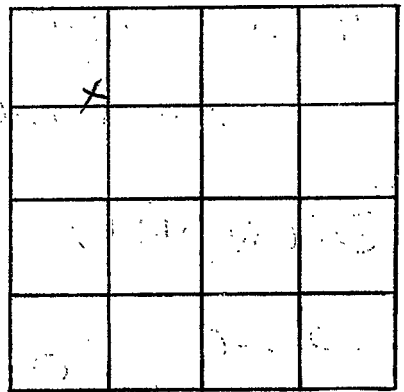

SECTION 933

Please indicate well location X.

ADDITIONAL INFORMATION

Lined area for additional information.

If more than one screen, show locations of each on sketch.