

Gw 4813 Elev. 140
SE/SE, Sec. 27.

Sunflower
C46
5-5-80

MISSISSIPPI
BOARD OF WATER COMMISSIONERS
416 North State Street
Jackson, Mississippi 39201

CODED

WATER WELL DRILLERS LOG

5/5 19 80 Dyer Sunflower
date well completed firm name county well located

LANDOWNER:
BUBBA SHURDEN
Drew, MS.
(mailing address)


description of formations encountered	from	to
Clay	0	28
fine sand	28	38
sand	38	48
sand & gravel	48	103

WELL LOCATION:
sec. 34 T 23 N R 4 E
4 miles W of Drew
(distance) (direction) (nearest town)

WELL PURPOSE: Drilling
(home, irrigation, municipal, industrial)

CODED

- WELL COMPLETION DATA:
- (1) diameter (inches) 12"
 - (2) total depth (feet) 103'
 - (3) static water level (feet) 19' below top of ground.
 - (4) casing Steel, 103' (material) (depth)
12" (size) If telescope see back.
 - (5) screen 40' 63' (length) (depth to top)
12" Steel (size) (material)
 - (6) pump 40 HP 2000 (HP) (yield gpm)
propeller (type power)
 - (7) electric log (yes or no)
(organization running log)
 - (8) how well bottom plugged plate

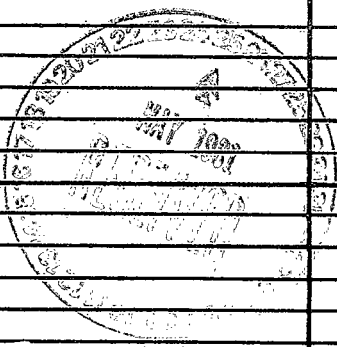

DRILLERS REMARKS:

If well telescopes please sketch and show depths.

GROUND LEVEL

X			

SECTION 34

Please indicate well location X.

ADDITIONAL INFORMATION

If more than one screen,
show locations of each on sketch.