

GW 4814
 NW/ NW, Sec. 35
 Elev. 140

Sunflower
C47
5-8-80

MISSISSIPPI
 BOARD OF WATER COMMISSIONERS
 416 North State Street
 Jackson, Mississippi 39201

CODED

WATER WELL DRILLERS LOG

5/8 1980 Dyer Sunflower
 date well completed firm name county well located

LANDOWNER:
BUBBA SHURDEN
DREW, MS
 (mailing address)

description of formations encountered	from	to
<u>Clay</u>	<u>0</u>	<u>28</u>
<u>Fine sand</u>	<u>28</u>	<u>40</u>
<u>Sand</u>	<u>40</u>	<u>45</u>
<u>Sand & Gravel</u>	<u>45</u>	<u>83</u>


WELL LOCATION:
 sec. 35 T 23 N R 4 E
4 miles W of Drew
 (distance) (direction) (nearest town)

WELL PURPOSE: Domestic
 (home, irrigation, municipal, industrial)

- WELL COMPLETION DATA:
- (1) diameter (inches) 12"
 - (2) total depth (feet) 103'
 - (3) static water level (feet) 20' below top of ground.
 - (4) casing Steel, 103'
 (material) (depth)
12" if telescope see back.
 (size)
 - (5) screen 40", 63'
 (length) (depth to top)
12", Steel
 (size) (material)
 - (6) pump 40 2000
 (HP) (yield gpm)
Diesel
 (type power)
 - (7) electric log
 (yes or no)

 (organization running log)
 - (8) how well bottom plugged plate


CODED

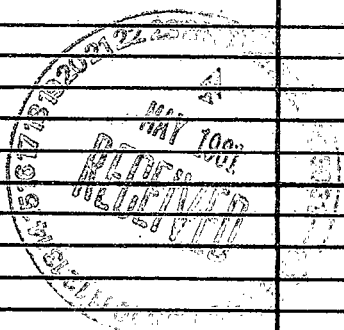

DRILLERS REMARKS:

If well telescopes please sketch and show depths.

GROUND LEVEL

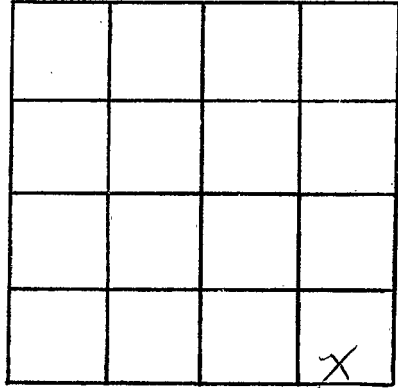

SECTION 345

Please indicate well location X.

ADDITIONAL INFORMATION

If more than one screen, show locations of each on sketch.