




If well telescopes please sketch and show depths.

GROUND LEVEL

23 ft water level

12" casing

40 ft - 12" screen

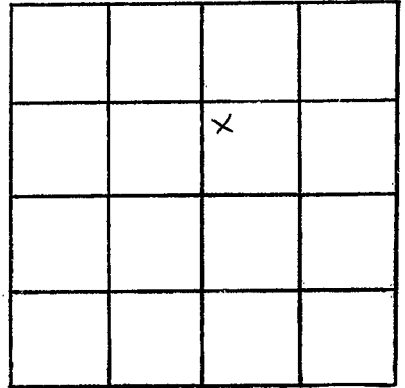

SECTION 25

Please indicate well location X.

ADDITIONAL INFORMATION

If more than one screen, show locations of each on sketch.