

MISSISSIPPI DEPARTMENT OF NATURAL RESOURCES

Bureau of Land and Water Resources

Southport Mall

P.O. Box 10631

Jackson, Mississippi 39209

WATER WELL DRILLERS LOG

CODED

SYNFLOWER  
 C 52  
 8/11/83

8-11  
 date well completed

1983 Powell IRN  
 firm name

SANFLOWER  
 county well located

| LANDOWNER:  | description of formations encountered | from | to |
|---|---------------------------------------|------|----|
| Drew PUBLIC SCHOOLS   |                                       |      |    |
| Drew Miss<br>(mailing address)  | CLAY                                  | 0    | 13 |
|   | FINE BROWN SAND                       | 13   | 23 |
|   | med GRAY SAND                         | 23   | 53 |
|   | COARSE SAND                           | 53   | 93 |
| WELL LOCATION:  |                                       |      |    |
| sec. 16 T. 23 N. R. 4 E. S. 5   |                                       |      |    |
| 7 miles NW of Drew<br>(distance) (direction) (nearest town)           |                                       |      |    |
| WELL PURPOSE: IRRIGATION<br>(home, irrigation, municipal, industrial) |                                       |      |    |
| WELL COMPLETION DATA:   |                                       |      |    |
| (1) diameter (inches) 10"   |                                       |      |    |
| (2) total depth (feet) 93'  |                                       |      |    |
| (3) static water level (feet) 28' below top of ground.                |                                       |      |    |
| (4) casing PVC, 53'<br>(material) (depth)                             |                                       |      |    |
| (size) if telescope see back.   |                                       |      |    |
| (5) screen 40', 53'<br>(length) (depth to top)                        |                                       |      |    |
| 10, PVC<br>(size) (material)  |                                       |      |    |
| (6) pump 10, 800<br>(HP) (yield gpm)                                  |                                       |      |    |
| ELC<br>(type power)   |                                       |      |    |
| (7) electric log (yes or no)  |                                       |      |    |
| (organization running log)  |                                       |      |    |
| (8) how well bottom plugged<br>PVC cap                                |                                       |      |    |
| DRILLERS REMARKS:   |                                       |      |    |

CODED


DEPT. OF NATURAL RESOURCES  
 BUREAU OF LAND & WATER RESOURCES

AUG 18 1983

RECEIVED

If well telescopes please sketch and show depths.

GROUND LEVEL

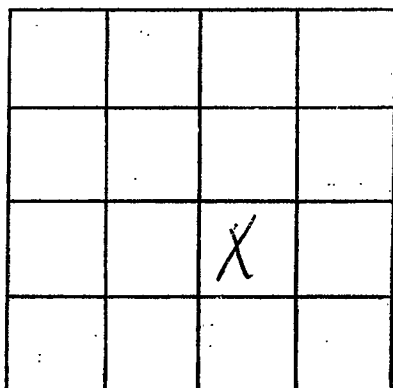

SECTION 16

Please indicate well location X.

ADDITIONAL INFORMATION

If more than one screen,  
show locations of each on sketch.