


If well telescopes please sketch and show depths.

GROUND LEVEL

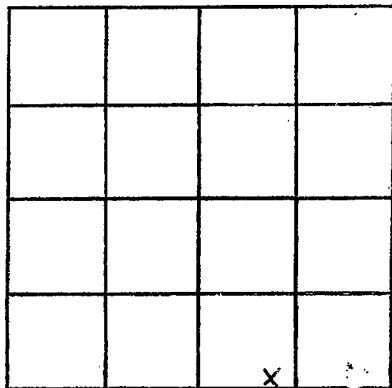

SECTION 23

Please indicate well location X.

ADDITIONAL INFORMATION

HOUSE ON MAIN Black Top
ROAD ON SOUTHER PLANTATION
ROAD.

If more than one screen,
show locations of each on sketch.