

MISSISSIPPI DEPARTMENT OF NATURAL RESOURCES

Bureau of Land and Water Resources

Southport Mall

P.O. Box 10631

Jackson, Mississippi 39209

WATER WELL DRILLERS LOG

Santowar
© 54

CODED

APR 11 1988 date well completed. COOK Drilling firm name Santowar county well located

LANDOWNER:	description of formations encountered	from	to
<u>Billy Stanford</u> <u>Stene miss</u> (mailing address)			
WELL LOCATION: sec. <u>30 T 22 N</u> R. <u>4 E</u> <u>5</u> miles <u>E</u> of <u>Merigold</u> (distance) (direction) (nearest town)			
WELL PURPOSE: <u>irrigation</u> (home, irrigation, municipal, industrial)			
WELL COMPLETION DATA:			
(1) diameter (inches) <u>10</u>			
(2) total depth (feet) <u>110</u>			
(3) static water level (feet) <u>40'</u> below above top of ground.			
(4) casing <u>PVC</u> <u>70'</u> (material) (depth)			
<u>10</u> if telescope see back. (size)			
(5) screen <u>40'</u> <u>70</u> (length) (depth to top)			
<u>10</u> <u>PVC</u> (size) (material)			
(6) pump <u>10</u> <u>500</u> (HP) (yield gpm)			
<u>Boyle</u> (type power)			
(7) electric log <u>no</u> (yes or no)			
(organization running log)			
(8) how well bottom plugged <u>Cap.</u>			

CODED

RECEIVED


SEP 29 1988

Department of Natural Resources
 Bureau of Land & Water Resources

DRILLERS REMARKS:

If well telescopes please
sketch and show depths.

GROUND LEVEL

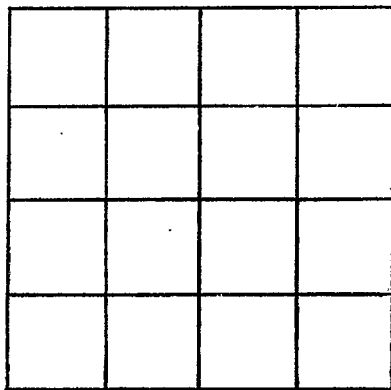

SECTION 30

Please indicate well location X.

ADDITIONAL INFORMATION

If more than one screen,
show locations of each on sketch.