

MISSISSIPPI DEPARTMENT OF NATURAL RESOURCES

Bureau of Land and Water Resources

Southport Mall

P.O. Box 10631

Jackson, Mississippi 39209

WATER WELL DRILLERS LOG

CODED

SUNFLOWER
C 57

7-23 1987
date well completed

Dyer Well
firm name

Sunflower
county well located

LANDOWNER: Wayne Parks
Rt 1 Box 37
Drew, Ms. 38737
(mailing address)

description of formations encountered

from

to

CLAY	0	20
Fine Sand + Clay	20	75
FINE SAND	45	75
M SAND + GRAVEL	75	80
SAND + GRAVEL	80	102

CODED

WELL LOCATION:

sec 25 T 23 N R 4 W
3 miles West of Drew
(distance) (direction) (nearest town)

WELL PURPOSE: IRRIGATION
(home, irrigation, municipal, industrial)

WELL COMPLETION DATA:

- (1) diameter (inches) 10"
- (2) total depth (feet) 102
- (3) static water level (feet) _____ below above top of ground.
- (4) casing PVC (material) _____ (depth) _____
10" (size) if telescope see back.
- (5) screen 40' (length) _____ (depth to top) _____
10" (size) _____ (material)
- (6) pump 15 (HP) 800 (yield gpm)
Electric (type power)
- (7) electric log No (yes or no)
None (organization running log)
- (8) how well bottom plugged Plate

RECEIVED


JUL 27 1987

Department of Natural Resources
Bureau of Land & Water Resources

DRILLERS REMARKS:

If well telescopes please sketch and show depths.

GROUND LEVEL

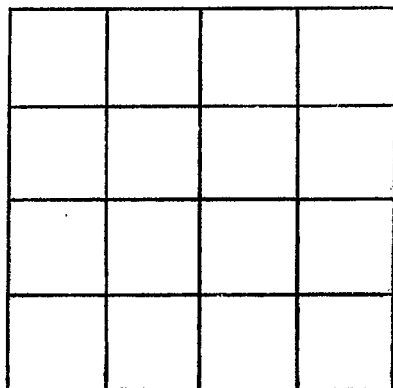

SECTION _____

Please indicate well location X.

ADDITIONAL INFORMATION

If more than one screen,
show locations of each on sketch.