		- State W	ell Report	
C£	10407		Part 1	For Office Use Only:
County:Sunf		Mississippi Department of Environmental Quality		Aquifer.
Permit #: GWA	1459	Office of Land	and Water Resources	Aquifer: Well #: <u>C -92</u>
Irrigation	Equipment		Box 10631	•
Date drilling completed	12-7-06	Jackson, M	AS 39289-0631)961-5210	L. S. Elevation:
Date drilling completed		(601)35	64-6938 (fax)	E-log #:
			defilier in detail and filed m	ith the Donartment within
	ures that this reputed in the second se		e driller in detail and filed w	th the beparement whim
	Well Owner Inform			Location
Owner NameAr	t Tidmore		33 46 38.0 Latitude:	N 90 34 40,5W "Longitude:
Mailing Address:	41 Tidmore	e Lane	A9 31 Method of Lat/Long (circle or	e): Conventional Survey,
			•	GPS, Survey-grade GPS
	Meridald	MS 38759	NW 1/4 NE 1/4 Sec_ 35	Twn 23N Rng 4W
City	St	ate Zip Code	Distance Direction	Nearest Town
·	662-745-2	317		of <u>Drew</u>
Telephone No. ()			
· · · · · · · · · · · · · · · · · · ·		Well	Data	
			well drilling completed: <u>12</u>	
Static Water Level:	<u>41</u> feet a	-	describe) land surface Date measured:	
		bove or below (circle one)		12-8-06
Method of Measureme	ent (circle one)	bove or below (circle one)	land surface Date measured:	12-8-06
Method of Measuremethole depth:1	ent (circle one) s	bove or below (circle one) seel tape electric tape epth:	land surface Date measured: air line other: Well grouted to a depth of	12-8-06
Method of Measuremethole depth:1	ent (circle one) s <u>14</u> Well de one): Cement	bove or below (circle one) seel tape electric tape epth:	land surface Date measured: air line other: Well grouted to a depth of	12-8-06 10 feet
Method of Measuremethole depth:1 Type of grout (circle of Casing length:74 Screen length:	ent (circle one) s 14 Well de one): Cement feet Case 40 feet Scr	bove or below (circle one) electric tape epth: 114 bentonite Mix ing diameter: 10 een diameter: 10	land surface Date measured:	12-8-06 <u>10</u> feet PVC 160 PVC 160
Method of Measuremethole depth:1 Type of grout (circle of Casing length:74 Screen length:	ent (circle one) s 14 Well de one): Cement feet Case 40 feet Scr	bove or below (circle one) electric tape epth: 114 bentonite Mix ing diameter: 10 een diameter: 10	land surface Date measured: air line other: Well grouted to a depth of inches Type of casing:	12-8-06 <u>10</u> feet PVC 160 PVC 160
Method of Measuremethole depth:1 Type of grout (circle of Casing length: Screen length: Screen slot size:	ent (circle one) s <u>14</u> Well de one): Cement <u>feet</u> Cass <u>40</u> feet Scr <u>050</u> inches	bove or below (circle one) electric tape epth: 114 Bentonite Mix ing diameter: 10 een diameter: 10 Setting depth: From	land surface Date measured:	12-8-06 <u>10</u> feet PVC 160 PVC 160 <u>114</u> feet
Method of Measuremethole depth:1 Type of grout (circle of Casing length: Screen length: Screen slot size:	ent (circle one) s <u>14</u> Well de one): Cement <u>feet</u> Cass <u>40</u> feet Scr <u>050</u> inches	above or below (circle one) seel tape electric tape epth: 114 Bentonite Mix ing diameter: 10 een diameter: 10 Setting depth: From _ : Gravel packet Unde	land surface Date measured:	12-8-06 <u>10</u> feet <u>PVC 160</u> <u>PVC 160</u> <u>114</u> feet hole Natural Development
Method of Measuremethole depth:1 Type of grout (circle of Casing length:74 Screen length: Screen slot size: Type of completion (completion)	ent (circle one) s <u>14</u> Well de one): Cement <u>feet</u> Cas <u>40</u> feet Scr <u>050</u> inches circle all applicable)	bove or below (circle one) seel tape electric tape epth: 114 Bentonite Mix ing diameter: 10 een diameter: 10 Setting depth: From : Gravel packed Unde Other (describe):	land surface Date measured:	12-8-06 <u>10</u> feet <u>PVC 160</u> <u>PVC 160</u> <u>114</u> feet hole Natural Development
Method of Measuremethole depth:1 Type of grout (circle of Casing length:74 Screen length: Screen slot size: Type of completion (contents)	ent (circle one) s <u>14</u> Well de one): Cement <u>feet</u> Cass <u>40</u> feet Scr <u>050</u> inches circle all applicable) uction in casing:	bove or below (circle one) seel tape electric tape epth: <u>114</u> Bentonite Mix ing diameter: <u>10</u> een diameter: <u>10</u> Setting depth: From : Gravel packet Unde Other (describe): feet. If te	land surface Date measured:	12-8-06 10 feet PVC 160 PVC 160 114 feet hole Natural Development
Method of Measuremethole depth:1 Type of grout (circle of Casing length:74 Screen length: Screen slot size: Type of completion (context) Top of lap pipe or reduced Logs run (circle all approximation)	ent (circle one) s <u>14</u> Well de one): Cement <u>feet</u> Cass <u>40</u> feet Scr <u>050</u> inches circle all applicable) uction in casing: plicable): No log ru running log(s):	bove or below (circle one) seel tape electric tape epth:	land surface Date measured:	12-8-06 10 feet PVC 160 PVC 160 114 feet hole Natural Development een, describe on back of page Other:
Method of Measuremethole depth:1 Type of grout (circle of Casing length: Screen length: Screen slot size: Type of completion (c Top of lap pipe or redu Logs run (circle all ap <u>Name of organization</u> I certify that the well	ent (circle one) s <u>14</u> Well de one): Cement <u>40</u> feet Cas <u>40</u> feet Scr <u>050</u> inches circle all applicable) uction in casing: pplicable): No log running log(s): twas drilled, const	bove or below (circle one) electric tape epth: 114 Bentonite Mix ing diameter: 10 een diameter: 10 Setting depth: From : Gravel packet Unde Other (describe): feet. If te unde Electric Gamma Ray	land surface Date measured:	12-8-06 10 feet PVC 160 PVC 160 114 feet hole Natural Development een, describe on back of page Other:
Method of Measuremethole depth:1 Type of grout (circle of Casing length: Screen length: Screen slot size: Type of completion (c Top of lap pipe or red Logs run (circle all ap <u>Name of organization</u> I certify that the well Department of Envir	ent (circle one) s <u>14</u> Well de one): Cement <u>feet</u> Case <u>40</u> feet Scr <u>050</u> inches circle all applicable) fuction in casing: pplicable): No log running log(s): was drilled, constr ronmental Quality	bove or below (circle one) seel tape electric tape epth:	land surface Date measured:	12-8-06 10 feet PVC 160 PVC 160 114 feet hole Natural Development een, describe on back of page Other:
Method of Measuremethole depth:1 Type of grout (circle of Casing length:74 Screen length: Screen length: Type of completion (circle all apple or reduced Logs run (circle all apple or reduced) Name of organization I certify that the well Department of Envir Irrigat	ent (circle one) s <u>14</u> Well de one): Cement <u>40</u> feet Cas <u>40</u> feet Scr <u>050</u> inches circle all applicable) uction in casing: pplicable): No log running log(s): twas drilled, const	bove or below (circle one) seel tape electric tape epth:	land surface Date measured:	12-8-06 10 feet PVC 160 PVC 160 114 feet hole Natural Development een, describe on back of page Other:


.

DEC 2 9 2006 BY: OLWP If well telescopes please sketch below and show depths.

Ground Level

Description of Formations Encountered	From To
	0 25
Clay Fine Sand	26 35
Fine Sand/gravel	36 50
Fine Sand/gravel Med. Sand/gravel	59 11 1
ried. Sand/glavel	
· · · · · · · · · · · · · · · · · · ·	
······································	
· · · ·	
	Land and the second sec

If more than one screen, show location of each on sketch

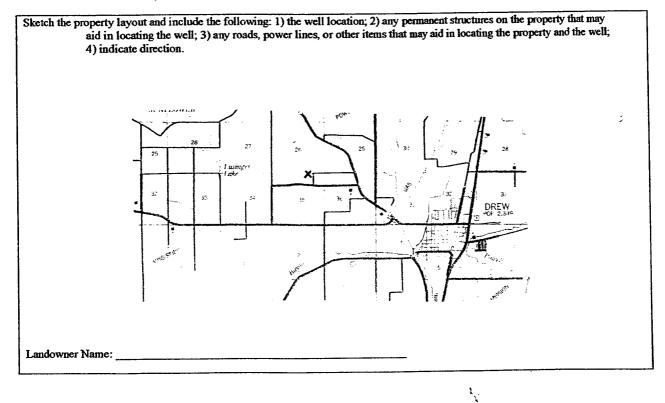

Signature of Water Well Contractor

County: Sunflower	Part 2 Pump Installer's Completion Report	For Office Use Only:
Permit#_ <u>GW41459</u> Irrigation Equipment Driller:	Mississippi Department of Environmental Quality Office of Land and Water Resources P.O. Box 10631 Jackson, MS 39289-0631	Aquifer: Well #: <u>C - 92</u>
Date completed:12-7-06	(601)961-5210 (601)354-6938 (fax)	Elevation:

.

•

F

V	Vell Owner Inform	nation		Well Location	
Owner Name:	Art Tidmoi	re	Latitude:	Longitude:	
Mailing Address:	41 Tidmore	e Lane	Method of Lat/Long (circle one): Conventional Survey,		
City	y Stat 2-745-231	•	<u>NW</u> <u>NE</u> Distance	quad, Hand-held GPS, S ¹ / ₄ Sec ³⁵ Twn_ ² Direction Nearest ^W of_ ^{Drew}	^{3N} Rng ⁴ W
	Pump Type			Power Type	
	Circle one			Circle one	
Air Lift		Submersible	Diesel Engine		Natural Gas
Air Lift Bucket	Circle one	Submersible	Diesel Engine Electric Motor	Circle one	Natural Gas Tractor PTO
	Circle one Jet			Circle one Gasoline Engine	Tractor PTO
Bucket	Circle one Jet Piston Rotary	Turbine Flowing Well	Electric Motor Windmill	Circle one Gasoline Engine Hand	
Bucket Centrifugal	Circle one Jet Piston Rotary	Turbine Flowing Well	Electric Motor Windmill	Circle one Gasoline Engine Hand Other (specify): ng of Motor:1 5	

Pump Test Data	Method of Measuring Water Level		
Date Well Tested:	Circle one		
Static Water Level (A):Feet Below Land Surface	Air Line Electric Measuring Line Steel Tape		
Pumping Water Level (B):Feet Below Land Surface	Other (specify):		
Drawdown [(B) - (A)]:Feet Below Land Surface	For flowing well, measured shut in head:feet		
Test Pumping Rate:Gallons Per Minute	Well yielded GPM with a drawdown of		
Duration of Pump Test (minimum 4 hours):hours	feet afterhours of pumping		

I HEREBY CERTIFY that the above statements are true to the best of	f my moviledge.	
Patrick M. Chism 0695	Patri MCh	RECEIVED
Print Name of Pump Installer and License No. (if applicable)	V Signature of Pump Installer	
		DEC 2 9 2006

BY: OLWR