
GW43283	State Well R	eport 🚬 🔽	For Office Use Only:	
Simplower	Part 1			
549	Mississippi Department of Environmental Quality		Aquifer:	-
ermit #:	Office of Land and Water Resources P.O. Box 10631			-
riller. <u>J. 1705-101</u> C. 11/1109	Jackson, MS 39289-0631		L. S. Elevation:	-
Date drilling completed: <u>6110109</u>	(601)961-5210 (601)354-6938 (fax)		E-log #:	
		- in detail and filed w	ith the Department within	
State Law requires that this rep 30 days of completion of drilling	ort be prepared by the united of the well.			 .
Well Owner Informs	ation		Location	
wher ivanie		3	ongitude <u>C0°35'02</u>	-
Talling Addics L_			ne): Conventional Survey.	
PO Box	52		i GPS, Survey-grade GPS	·
Ieland 1	WS 38.06 12		Twn BV Rng 400	-
0.0	tate Zip Code NE Dist	ance Direction Miles	Nearest Town	
Telephone No COD - 870-	-52 <u>63</u> 2	.)_Miles_N_	of Durging	
	Well Data			
	Annal Bublic Supply Int	gation Fish Culture	Other:	
Purpose of Well (circle one) Home In		\sim	116109	
Date well drilling started: 610	Date well of	Irilling completed:		
If flowing, method of flow regulation: N	alve Other (descri	be)	C_{1009}	
Static Water Level:feet	above or below (circle one) land	surface Date measured	$\frac{1}{10}$	
Method of Measurement (circle one)	(steel tape) electric tape	air line other:		
50	depth: 120 1	Well grouted to a depth o	ffeet	
•				
Type of grout (circle one): Cement	Bentonite Mix		DUC	
Casing length: 50 feet C	asing diameter: <u>16</u> in	ches Type of casing	Dic	
Screen length: <u>40</u> feet S	creen diameter: <u>. \ Co</u> in	nches Type of screen:	FUC	
Screen slot size: . 050 inche	s Setting depth: From	<u>60</u> feet to	20 feet	
			en hole Natural Developmen	t
Type of completion (circle all applicab			_	
	Other (describe):			
Top of lap pipe or reduction in casing:	feet. If teleso	coped or more than one	screen, describe on back of page	e
Logs run (circle all applicable): No log	g run Electric Gamma Ray I	Density Sonic Neutron	a Other:	
Name of organization running log(s):				
I certify that the well was drilled, co	nstructed, and completed in acco	ordance with all applica	ble requirements of the Mississi	ıppi
Department of Environmental Quali	ty and/or the Mississippi Depart	ment of Health regulation	ons and state laws.	
Donnes Happe	r 0-542		Lamer Hagger	/
Print Name of Water Well Contractor	· · ·	Signatu	re of Water Well Contraction	REC
L				IEU

If well telescopes please sketch below and show depths.

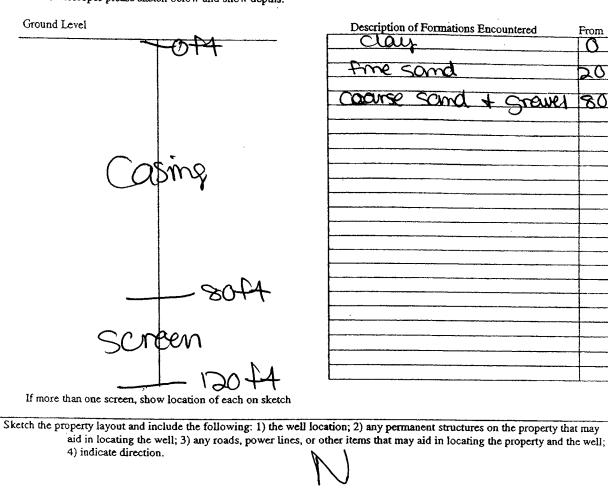

C108

From

(

20

Snewel

Τo

20

80

80 120

Millen lake Rd	
1 mite	
4 mire Slough	D'
	Que
	-0 ⁻⁶⁰
Landowner Name: Deer Creek Farms	

1 agur Signature of Water Well Contractor

· · · · · · · · · · · · · · · · · · ·						
		ELL REPORT				
County: Sunflower		art 2	For Office	For Office Use Only:		
	Mississippi Departmen	Completion Report t of Environmental Qualit		ose omy.		
Permit #:	Office of Land and Water Resources		y Aquifer.			
Driller: J. HOOGEN	P.O. Box 10631 Jackson, MS 39289-0631		Well #: 6	108		
Date completed:	(601)	961-5210				
	4-6938 (fax)	fievation:	Elevation:			
This report should be prepared by th installation of pump.		l and filed with the Depa	urtiment within 30 days	of the		
Well Owner Informat	tion		Well Location			
Owner Name: Deer Creek	5 Herms	Latitude: 33°53'	02.9 _ ongitude 90	35'02"		
Mailing Address: CB BIII M	auton		<u>0</u> 3'			
DAPAS	\sim	Method of Lat/Long (cir		ì		
PU DUX			Hand-held GPS Surve			
Leland N		1/2 1/4 NW 1/4 Se	2 11/Twn 220	Rng 4W		
City State	Zip Code	NE Distance Direct				
Telephone No. (62 820 - 52	62			- Chine		
		2.5 Miles N	of	Dua		
D		· · · · · · · · · · · · · · · · · · ·	· · · · · · · · · · · · · · · · · · ·			
Pump Type Circle one			Power Type Circleione			
Air Lift Jet '	Submersible	Diesel Engine	Basoline Engine	Natural Gas		
Bucket Piston	Turbine	Electric Motor	Hand	Tractor PTO		
Centrifugal Rotary	Flowing Well		Other (specify):	Hactor P I O		
Other (specify).		Horse Power Rating of 1	$\hat{\mathbf{C}}$			
Date Pump Installed: 6/11/09	· · · · · · · · · · · · · · · · · · ·		$7 \land$			
		Setting Depth:	$\overline{\mathbf{A}}$	feet		
Rated Pump Capacity: 2400	_Gallons Per Minute	Number of Stages:	<u>`</u>	,		
		<u> </u>				
Pump Test Data		Method	of Measuring Water Le	evel		
Date Well Tested:			Circle one			
		Air Line Electri	c Measuring Line	Steel Tape		
AND	t Below Land Surface	Other (specify):				
Pumping Water Level (B):Feet	Below Land Surface					
Drawdown [(B) - (A)]:Fee	t Below Land Surface	For flowing well, measu	ured shut in head	feet		
Test Pumping Rat CLOU	Gallons Per Minute	Well yielded				
Duration of Pump Terr						
Duration of Pump Test (minimum 4 hours)	bours	feet ;	after hou	urs of pumping		
		·····				
I HEREBY CERTIFY that the above states	ments are true to the best of	of my knowledge.	\frown			
[ML ROIN	QUIL-O P		ON.			
Print Name of Pump Installer and License	No. (if applicable)	Signature of Pr	ump Installer	RECEIVE		
				JUL 1 5 2009		
				BY: OLW		