

Sunflower  
C. 2000  
6-29-76

MISSISSIPPI  
 BOARD OF WATER COMMISSIONERS  
 416 North State Street  
 Jackson, Mississippi 39201

WATER WELL DRILLERS LOG

BUTANE GAS CO. OF GREENWOOD

6-29-76  
 date well completed

19

firm name

Sunflower  
 county well located

LANDOWNER:	description of formations encountered	from	to
A.C. Tidmore			
<u>Drew</u> (mailing address)	Clay	0	3
	Sand	3	84
	Pea Gravel	84	95
WELL LOCATION:	Clay	95	154
sec. <u>24</u> T. <u>23</u> N. R. <u>4</u> E. W. <u>W</u>	Sand	154	290
<u>3</u> miles <u>SW</u> of <u>Drew</u>	Brown Shale	290	315
(distance) (direction) (nearest town)	Sand	315	370
WELL PURPOSE: <u>Home</u> (home, irrigation, municipal, industrial)	Shale + Rock	370	510
WELL COMPLETION DATA:	Sand	510	546
(1) diameter (inches) <u>4 7/8</u>	Shale	546	631
(2) total depth (feet) <u>1176</u>	Sand	631	645
(3) static water level (feet) <u>11</u> below top of ground.	Shale	645	729
(4) casing <u>Steel</u> , <u>11 5/8"</u> , (material) (depth)	Shale + Rock	729	789
<u>4 7/8"</u> if telescope see back. (size)	Rock	789	793
(5) screen <u>20</u> , <u>11 5/8"</u> (length) (depth to top)	Shale + Rock	793	873
<u>2</u> , <u>Stainless</u> (size) (material)	Shale	873	954
(6) pump <u>1</u> , <u>19</u> (HP) (yield gpm)	Sandy Shale	954	980
<u>Elec.</u> (type power)	Sand	980	1012
(7) electric log <u>No</u> (yes or no)	Shale	1012	1065
(organization running log)	Sand	1065	1102
	Shale	1102	1147
(8) how well bottom plugged <u>BACK PRESSURE VALVE</u>	Sand	1147	1185
	Shale	1185	1192
DRILLERS REMARKS:			

RECEIVED  
 JUL 13 1976  
 MISS. Bd. OF WATER COMM


If well telescopes please sketch and show depths.

GROUND LEVEL

105' - 4" CASING →

105' - 2" CASING →

20' - 2" SCREEN →

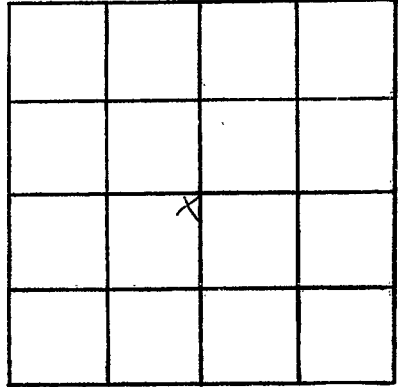

SECTION 2f

Please indicate well location X.

ADDITIONAL INFORMATION

If more than one screen,  
show locations of each on sketch.