

SUNFLOWER

C 2001

3-31-77

MISSISSIPPI BOARD OF WATER COMMISSIONERS

416 North State Street

15H Jackson, Mississippi 39201

WATER WELL DRILLERS LOG

Nov 31 1977
date well completed

Dallas Well Supply
firm name

Sunflower Co
county well located

LANDOWNER: Morgan Thompson

description of formations encountered

from to

Brew Miss
(mailing address)

WELL LOCATION:

sec. 28 T 23 N R 4 E
S W

4 miles NW of Brew
(distance) (direction) (nearest town)

WELL PURPOSE: Home
(home, irrigation, municipal, industrial)

WELL COMPLETION DATA:

- (1) diameter (inches) 4" x 2"
- (2) total depth (feet) 693
- (3) static water level (feet) 39 below top of ground.

(4) casing 4"
(material) (depth)
(size) if telescope see back.

(5) screen 20
(length) (depth to top)
2" stainless steel
(size) (material)

(6) pump 1 20
(HP) (yield gpm)
Ele
(type power)

(7) electric log No
(yes or no)

(organization running log)

(8) how well bottom plugged BP. Valve

DRILLERS REMARKS:



RECEIVED

JUN 24 1977

MISS. BD OF WATER COMM

If well telescopes please sketch and show depths.

GROUND LEVEL

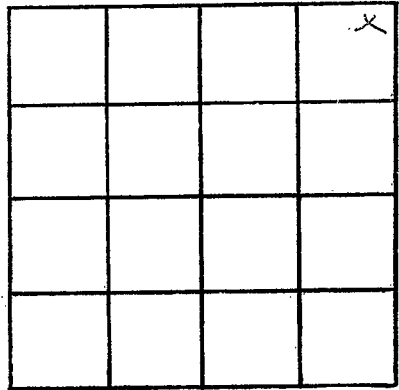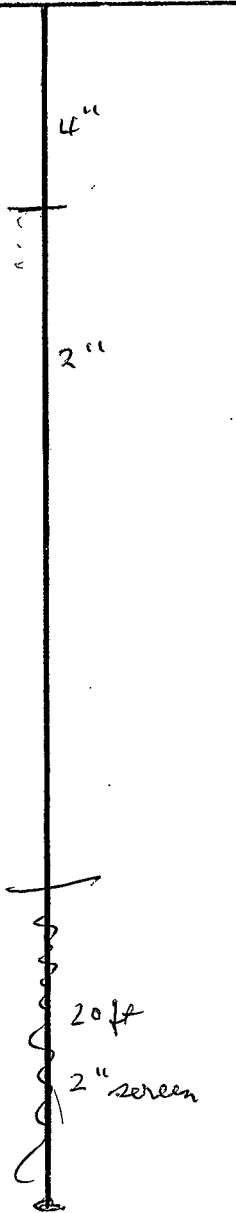

SECTION 28

Please indicate well location X.

ADDITIONAL INFORMATION

If more than one screen, show locations of each on sketch.