

MISSISSIPPI DEPARTMENT OF NATURAL RESOURCES

Bureau of Land and Water Resources

Southport Mall

P.O. Box 10631

Jackson, Mississippi 39209

WATER WELL DRILLERS LOG

Sunflower  
Caddo

9-30 1986 Scholtz Drilling Sunflower  
date well completed firm name county well located

LANDOWNER: CE. Williams  
Rt. 1. Box 34  
Merigold, MS  
(mailing address)

WELL LOCATION:  
sec 31 T 23 N R 4 E  
S miles E of Merigold  
(distance) (direction) (nearest town)

WELL PURPOSE: HOME  
(home, irrigation, municipal, industrial)

- WELL COMPLETION DATA:
- (1) diameter (inches) 4" x 2"
  - (2) total depth (feet) 100'
  - (3) static water level (feet) 52' below top of ground.
  - (4) casing PVC, 680'  
(material) (depth)  
(size) if telescope see back.
  - (5) screen 20', 680'  
(length) (depth to top)  
2', PVC  
(size) (material)
  - (6) pump 1, 19  
(HP) (yield gpm)  
elc  
(type power)
  - (7) electric log no  
(yes or no)  
✓  
(organization running log)
  - (8) how well bottom plugged b/w


description of formations encountered	from	to
CLAY	0	10
COARSE SAND	10	60
GRAVEL -	60	135
SAND	135	210
SHALE	210	360
SAND + SHALE	360	400
CLAY	400	600
SAND	600	700

RECEIVED  
OCT 15 1986

Department of Natural Resources  
Bureau of Land & Water Resources

DRILLERS REMARKS:


If well telescopes please sketch and show depths.

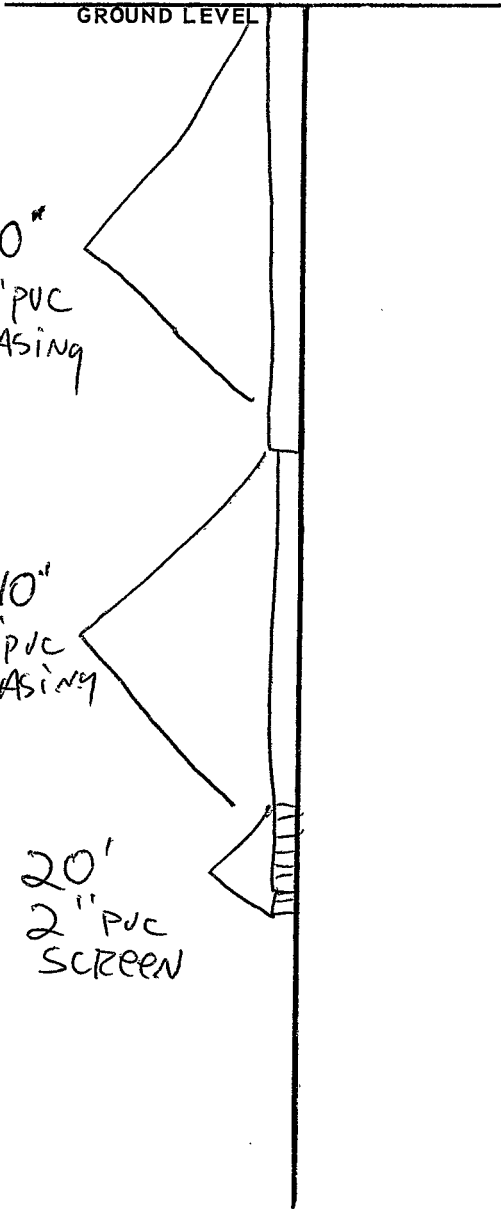

140"  
4" PVC  
CASING

540"  
2" PVC  
CASING

20'  
2" PVC  
SCREEN

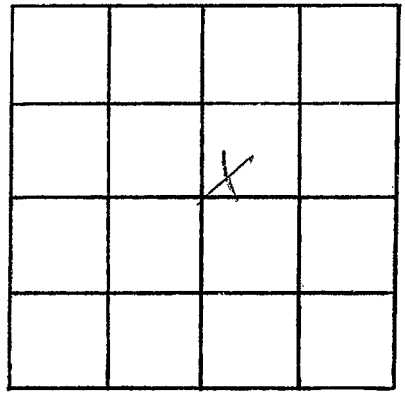

SECTION 31

Please indicate well location X.

**ADDITIONAL INFORMATION**

---

---

If more than one screen,  
show locations of each on sketch.