

MISSISSIPPI DEPARTMENT OF ENVIRONMENTAL QUALITY

Office of Land and Water Resources

P. O. Box 10631
Jackson, MS 39289-0631

WATER WELL DRILLERS LOG

COUNTY WELL LOCATED <i>Sunflower</i>	
WELL NUMBER	CODED
DATE WELL COMPLETED <i>2000</i> <i>April 19, 1994</i>	

PERMIT NUMBER
NAME OF DRILLING FIRM <i>Randy Well & Pump</i>

NAME & MAILING ADDRESS OF LANDOWNER <i>Barry Haynes</i> <i>141 S. Main</i> <i>Drew, Mo. 38737</i>			
WELL LOCATION	SEC	TOWNSHIP	RANGE
	<i>29</i>	<i>23</i>	<i>14 W</i>
DISTANCE	DIRECTION	NEAREST TOWN	
<i>7 1/2</i> Miles	<i>West</i>	of <i>Drew</i>	
OTHER LANDMARK <i>Near Sunflower Association</i>			
WELL PURPOSE: Home Irrigation, Municipal, Industrial, Fish Pond, etc.			

PUMP DATA		
PUMP TYPE (Circle One): Submersible, <u>Turbine</u> , Jet, Flowing Well, Other (Describe)		
POWER TYPE (Circle One): Electric, Tractor, <u>Diesel</u> , Gasoline, Butane, Other (Describe) H/P <i>20</i>		
Pump Capacity (GPM) <i>1200</i>	No. of Stages <i>2</i>	Setting Depth <i>60</i> FT.
PUMP TEST		
Well yielded _____ GPM with a drawdown of _____ ft. after _____ hours of pumping		

WELL DATA		
Well Depth <i>100'</i>	Casing Diameter (In.) <i>10"</i>	Casing Length (Ft.) <i>60'</i>
Type of Casing <i>Steel</i>	Hole Depth <i>100'</i>	Depth to Static Water Level
TYPE OF COMPLETION: (Circle One or More): <u>Gravel Packed</u> , Underreamed, Telescoped, Natural Development, Open Hole, Other (Describe)		
WELL GROUTED TO A DEPTH OF _____ FEET Type Grout (circle one): Cement, Bentonite, or Mix		

LOG DATA	
TYPE OF LOG RUN (Circle One): Electric, Gamma Ray, Density, Sonic, <u>No Log Run</u> , Neutron, Other (Describe)	
Name of Organization Running Log	

SCREEN DATA		
Diameter - Inches <i>10"</i>	Length - Feet <i>40'</i>	Slot Size - Inches <i>30</i>
Screen Type <i>Steel</i>	Depth to Bottom - Feet <i>100</i>	

GEOLOGIC DATA (Office Use Only)			
Surface Elev.	Geologic Unit	Unit Thickness	Depth to Top
Subs. SWL	Date	Analysis	Aquifer Test
Driller's Remarks			
Top of Lap Pipe or Reduction in Casing			
FEET		IF TELESCOPED OR MORE THAN ONE SCREEN: USE BACK PAGE	


DESCRIPTION OF FORMATIONS ENCOUNTERED	FROM	TO
<i>Clay</i>	<i>0</i>	<i>8</i>
<i>Coarse Sand</i>	<i>8</i>	<i>90</i>
<i>Coarse Sand + Rocks</i>	<i>90</i>	<i>100</i>
<i>Clay</i>	<i>100</i>	<i>101</i>

FORMATIONS (Continued)	FROM	TO
RECEIVED		
SEP 22 1994		
Dep. _____	City _____	
Office of Land & Water Resources		
IF MORE SPACE IS NEEDED, USE BACK		

Peacock

If well telescopes please sketch and show depths.

GROUND LEVEL

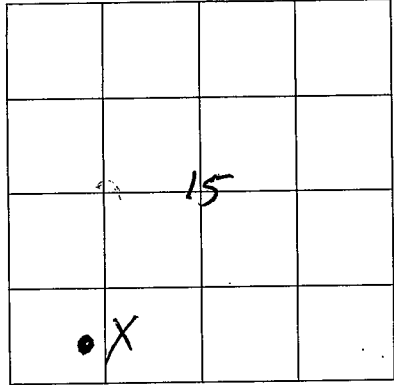

SECTION 29

Please indicate well location X.

ADDITIONAL INFORMATION

*located on Palmec
Road*

If more than one screen,
show location of each on sketch.