

MISSISSIPPI DEPARTMENT OF ENVIRONMENTAL QUALITY

Office of Land and Water Resources

P. O. Box 10631
Jackson, MS 39289-0631
WATER WELL DRILLERS LOG

COUNTY WELL LOCATED <i>Sunflower</i>	
WELL NUMBER <i>C</i>	CODED
DATE WELL COMPLETED <i>2007 April 19 1994</i>	

PERMIT NUMBER
NAME OF DRILLING FIRM <i>Lump Well & Pump</i>

NAME & MAILING ADDRESS OF LANDOWNER <i>Robert Haynes</i>		
<i>Hwy. 49 W</i>		
<i>Drew, Mo. 38737</i>		
WELL LOCATION: SEC	TOWNSHIP	RANGE
<i>8</i>	<i>32 23</i>	<i>N RAW E W</i>
DISTANCE	DIRECTION	NEAREST TOWN
<i>8</i> Miles	<i>west</i>	<i>Drew</i>
OTHER LANDMARK <i>New Sunflower Water Ass.</i>		
WELL PURPOSE: Home, Irrigation, Municipal, Industrial, Fish Pond, etc.		

PUMP DATA		
PUMP TYPE (Circle One): <input checked="" type="radio"/> Submersible, Turbine, Jet, Flowing Well, Other (Describe) _____		
POWER TYPE (Circle One): <input checked="" type="radio"/> Electric, Tractor, Diesel, Gasoline, Butane, Other (Describe) _____ H/P <i>15</i>		
Pump Capacity (GPM) <i>900</i>	No. of Stages <i>1</i>	Setting Depth <i>60</i> FT.
PUMP TEST		
Well yielded _____ GPM with a drawdown of _____ ft. after _____ hours of pumping		

WELL DATA		
Well Depth <i>115'</i>	Casing Diameter (In.) <i>8"</i>	Casing Length (Ft.) <i>75</i>
Type of Casing <i>PVC</i>	Hole Depth <i>115'</i>	Depth to Static Water Level

LOG DATA	
TYPE OF LOG RUN (Circle One): Electric, Gamma Ray, Density, Sonic, Neutron, Other (Describe) _____	
<i>No Log Run</i>	
Name of Organization Running Log	

TYPE OF COMPLETION: (Circle One or More): <input checked="" type="checkbox"/> Gravel Packed, <input type="checkbox"/> Underreamed, <input type="checkbox"/> Telescoped, <input type="checkbox"/> Natural Development, <input type="checkbox"/> Open Hole, <input type="checkbox"/> Other			
WELL GROUTED TO A DEPTH OF _____ FEET Type Grout (circle one): Cement, Bentonite, or Mix			

GEOLOGIC DATA (Office Use Only)			
Surface Elev.	Geologic Unit	Unit Thickness	Depth to Top
Subs. SWL	Date	Analysis	Aquifer Test

SCREEN DATA		
Diameter - Inches <i>8"</i>	Length - Feet <i>40'</i>	Slot Size - Inches <i>.30</i>
Screen Type <i>PVC</i>	Depth to Bottom - Feet <i>115'</i>	

Driller's Remarks	
Top of Lap Pipe or Reduction in Casing	
FEET	IF TELESCOPED OR MORE THAN ONE SCREEN: USE BACK PAGE


DESCRIPTION OF FORMATIONS ENCOUNTERED	FROM	TO	FORMATIONS (Continued)	FROM	TO
<i>Clay</i>	<i>0</i>	<i>10</i>	RECEIVED		
<i>Coarse sand</i>	<i>10</i>	<i>85</i>			
	<i>85</i>	<i>115</i>			
			SEP 22 1994		
			Office of Land & Water Resources		

Peacock

IF MORE SPACE IS NEEDED, USE BACK

If well telescopes please sketch and show depths.

GROUND LEVEL

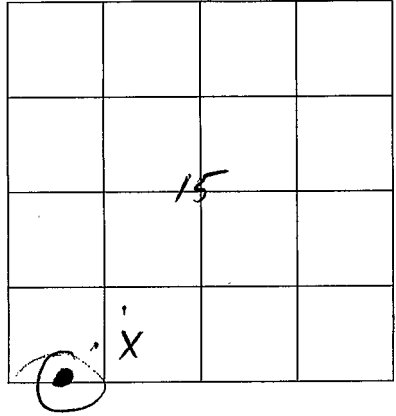

SECTION 32

Please indicate well location X.

ADDITIONAL INFORMATION

Near Sunflower
Water Ass

If more than one screen,
show location of each on sketch.