

**MISSISSIPPI DEPARTMENT OF ENVIRONMENTAL
QUALITY**

Office of Land and Water Resources

P. O. Box 10631
Jackson, MS 39289-0631

WATER WELL DRILLERS LOG

COUNTY WELL LOCATED SUNFLOWER	
WELL NUMBER <u>C</u>	CODED
DATE WELL COMPLETED <u>2008</u> <u>03/28/95</u>	

PERMIT NUMBER
NAME OF DRILLING FIRM LAYNE-CENTRAL

NAME & MAILING ADDRESS OF LANDOWNER HOLDER FISH FARM			
RT 1, BOX 97			
TUTWILER, MS 38963			
WELL LOCATION.	SEC	TOWNSHIP	RANGE
<u>SUNFLOWER</u>	<u>4</u>	<u>23</u>	<u>N</u> <u>4</u> <u>W</u>
DISTANCE	DIRECTION	NEAREST TOWN	
<u>5</u> Miles	<u>S</u>	of <u>ROUNDAWAY</u>	
OTHER LANDMARK FISH FARM			
WELL PURPOSE: Home, Irrigation, Municipal, Industrial, Fish Pond, etc. IRRIGATION			

PUMP DATA		
PUMP TYPE (Circle One): Submersible , <u>Turbine</u> , Jet , Flowing Well Other (Describe) _____		
POWER TYPE (Circle One): <u>Electric</u> , Tractor , Diesel , Gasoline , Butane Other (Describe) _____ H/P _____		
Pump Capacity (GPM)	No. of Stages	Setting Depth
<u>2000 GPM</u>	<u>1</u>	<u>60</u> FT.
PUMP TEST		
Well yielded <u>NOT TESTED</u> GPM with a drawdown of _____ ft. after _____ hours of pumping		

WELL DATA		
Well Depth	Casing Diameter (In.)	Casing Length (Ft.)
<u>122'</u>	<u>16"</u>	<u>82'</u>
Type of Casing	Hole Depth	Depth to Static Water Level
<u>STEEL</u>	<u>122'</u>	
TYPE OF COMPLETION: (Circle One or More): <u>Gravel Packed</u> , Underreamed , Telescoped , Natural Development , Open Hole , Other (Describe) _____		
WELL GROUTED TO A DEPTH OF <u>10</u> FEET Type Grout (circle one): <u>Cement</u> , Bentonite , Mix		

LOG DATA	
TYPE OF LOG RUN (Circle One): <u>Electric</u> , Gamma Ray , Density , Sonic , Neutron , Other (Describe) _____	
Name of Organization Running Log	

SCREEN DATA		
Diameter - Inches	Length - Feet	Slot Size - Inches
<u>16"</u>	<u>40'</u>	<u>.050"</u>
Screen Type	Depth to Bottom - Feet	
<u>DOERR</u>	<u>122'</u>	


GEOLOGIC DATA (Office Use Only)			
Surface Elev.	Geologic Unit	Unit Thickness	Depth to Top
Subs. SWL	Date	Analysis	Aquifer Test
Driller's Remarks			
Top of Lap Pipe or Reduction in Casing			
FEET		IF TELESCOPED OR MORE THAN ONE SCREEN: USE BACK PAGE	

DESCRIPTION OF FORMATIONS ENCOUNTERED	FROM	TO
CLAY	0	20
SAND	20	55
COURSE SAND	55	80
GRAVEL SAND	80	104
CEMENTED ROCK	104	105
GRAVEL CEMENTED GRAVEL	105	122

FOR INFORMATION FROM		TO	
RECEIVED			
MAY 09 1995			
Dept. of Environmental Quality Office of Land & Water Resources			
IF MORE SPACE IS NEEDED, USE BACK			

If well telescopes please
sketch and show depths.

GROUND LEVEL

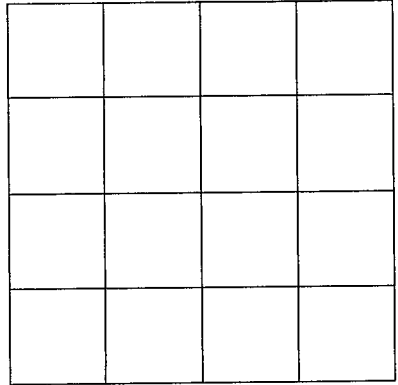

SECTION _____

Please indicate well location X.

ADDITIONAL INFORMATION

If more than one screen,
show location of each on sketch.