

MISSISSIPPI DEPARTMENT OF ENVIRONMENTAL QUALITY

Office of Land and Water Resources

P. O. Box 10631
Jackson, MS 39289-0631
WATER WELL DRILLERS LOG

COUNTY WELL LOCATED
SUNFLOWER

WELL NUMBER C CODED

2007

DATE WELL COMPLETED
04/15/95

PERMIT NUMBER

NAME OF DRILLING FIRM
LAYNE-CENTRAL

NAME & MAILING ADDRESS OF LANDOWNER

LEHRTON PLANTATION

285 GERMAN OAK DRIVE, SUITE 3

CORDOVA, TN 38018

WELL LOCATION: SEC TOWNSHIP RANGE
14 23 N 4 XX
W

DISTANCE DIRECTION NEAREST TOWN
5 Miles NW of DREW

OTHER LANDMARK

WELL PURPOSE: Home, Irrigation, Municipal, Industrial, Fish Pond, etc.
IRRIGATION

PUMP DATA

PUMP TYPE (Circle One):
~~Submersible~~ Turbine ~~Jet~~ ~~Flowing Well~~
Other (Describe)

POWER TYPE (Circle One):
~~Electric~~ ~~Friction~~ Diesel ~~Gasoline~~ ~~Butane~~
Other (Describe) H/P

Pump Capacity (GPM)	No. of Stages	Setting Depth
2500	1	60 FT.

PUMP TEST

Well yielded NOT TESTED GPM with
a drawdown of _____ ft.
after _____ hours of pumping

WELL DATA

Well Depth	Casing Diameter (In.)	Casing Length (Ft.)
124'	16"	74'
Type of Casing	Hole Depth	Depth to Static Water Level
STEEL	124'	31' 6"

TYPE OF COMPLETION: (Circle One or More):
Gravel Packed ~~Underreamed~~ ~~Telescoped~~
~~Natural Development~~ ~~Open Hole~~ ~~Other~~
(Describe)

WELL GROUTED TO A DEPTH OF 10 FEET
Type Grout (circle one): Cement ~~Bentonite~~ ~~Mix~~

LOG DATA

TYPE OF LOG RUN (Circle One): No Log Run, Electric, Gamma Ray, Density, Sonic, Neutron, Other (Describe)

Name of Organization Running Log

SCREEN DATA

Diameter - Inches	Length - Feet	Slot Size - Inches
16"	50'	.050"
Screen Type	Depth to Bottom - Feet	
DOERR	124'	

GEOLOGIC DATA (Office Use Only)

Surface Elev.	Geologic Unit	Unit Thickness	Depth to Top
Subs. SWL	Date	Analysis	Aquifer Test

Driller's Remarks

Top of Lap Pipe or Reduction in Casing

FEET IF TELESCOPED OR MORE THAN ONE SCREEN: USE BACK PAGE


DESCRIPTION OF FORMATIONS ENCOUNTERED	FROM	TO
CLAY	0	35
SAND	35	55
COURSE SAND	55	60
COURSE SAND GRAVEL	60	124

FORMATIONS (Continued)	FROM	TO
RECEIVED		
MAY 09 1995		
Dept. of Environmental Quality Office of Land & Water Resources		

IF MORE SPACE IS NEEDED, USE BACK

If well telescopes please
sketch and show depths.

GROUND LEVEL

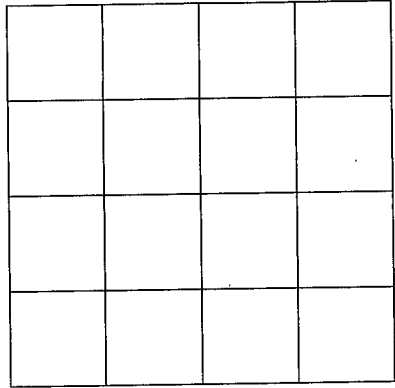

SECTION _____

Please indicate well location X.

ADDITIONAL INFORMATION

If more than one screen,
show location of each on sketch.