

**MISSISSIPPI DEPARTMENT OF ENVIRONMENTAL
QUALITY**

Office of Land and Water Resources

P. O. Box 10631
Jackson, MS 39289-0631
WATER WELL DRILLERS LOG

COUNTY WELL LOCATED Sunflower	
WELL NUMBER C 2016	CODED
DATE WELL COMPLETED 5-6-99	

PERMIT NUMBER
NAME OF DRILLING FIRM IRRIGATION EQUIPMENT
601/887-2555

NAME & MAILING ADDRESS OF LANDOWNER INDIANOLA, MS			
SUJO FARMS			
609 EAST Gresham St.			
INDIANOLA, MS 38751			
WELL LOCATION:	SEC	TOWNSHIP	RANGE
	36	23^N	4^W
DISTANCE	DIRECTION	NEAREST TOWN	
3	Miles NW	of Drew	
OTHER LANDMARK			
WELL PURPOSE: Home, Irrigation, Municipal, Industrial, Fish Pond, etc. Fish pond			

PUMP DATA		
PUMP TYPE (Circle One): Submersible, Turbine , Jet, Flowing Well, Other (Describe) _____		
POWER TYPE (Circle One): Electric, Tractor, Diesel , Gasoline, Butane, Other (Describe) _____ H/P 30		
Pump Capacity (GPM) 1500	No. of Stages 2	Setting Depth 70 FT.
PUMP TEST		
Well yielded _____ GPM with a drawdown of _____ ft. after _____ hours of pumping		

WELL DATA		
Well Depth 117	Casing Diameter (In.) 16	Casing Length (Ft.) 77
Type of Casing PVC	Hole Depth 117	Depth to Static Water Level 34 Ft.
TYPE OF COMPLETION: (Circle One or More): Gravel Packed , Underreamed, Telescoped, Natural Development, Open Hole, Other (Describe) _____		

LOG DATA	
TYPE OF LOG RUN (Circle One): Electric, Gamma Ray, Density, Sonic, Neutron, Other (Describe) _____ No Log Run,	
Name of Organization Running Log	

WELL GROUTED TO A DEPTH OF _____ FEET Type Grout (circle one): Cement, Bentonite, or Mix

GEOLOGIC DATA (Office Use Only)			
Surface Elev.	Geologic Unit	Unit Thickness	Depth to Top
Subs. SWL	Date	Analysis	Aquifer Test

SCREEN DATA		
Diameter - Inches 16	Length - Feet 40	Slot Size - Inches .050
Screen Type PVC	Depth to Bottom - Feet 117	


Driller's Remarks
Top of Lap Pipe or Reduction in Casing
FEET
IF TELESCOPED OR MORE THAN ONE SCREEN: USE BACK PAGE

DESCRIPTION OF FORMATIONS ENCOUNTERED	FROM	TO
clay	0	50
Fine sand	50	69
Fine sand & Gravel	69	75
med. sand & Gravel	75	117

FORMATIONS (Continued)	FROM	TO
RECEIVED		
SEP 01 1999		
Dept of Environmental Quality Office of Land and Water Resources		
IF MORE SPACE IS NEEDED, USE BACK		

If well telescopes please sketch and show depths.

GROUND LEVEL

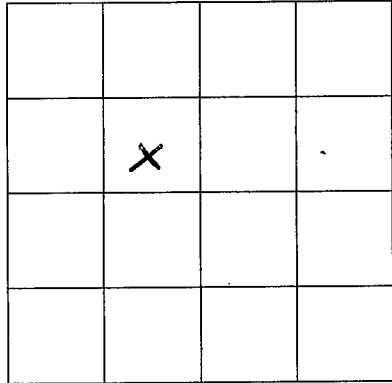

SECTION 36

Please indicate well location X.

ADDITIONAL INFORMATION

A series of horizontal lines provided for writing additional information.

If more than one screen, show location of each on sketch.