


SUNFLOWER
D
6-5-74

MISSISSIPPI
BOARD OF WATER COMMISSIONERS
416 North State Street
Jackson, Mississippi 39201

CODED

WATER WELL DRILLERS LOG

June 5 1974 Singer-Layne Central Div Sunflower
date well completed firm name county well located

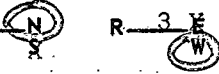LANDOWNER:	description of formations encountered	from	to
Wilton Hood			
Drew, Mississippi	Coarse Sand	16	40
(mailing address)	Gravel & Sand	40	107
WELL LOCATION:	Hard Rock	107	
sec. 13 T23  R. 3 E			
_____ miles _____ of Drew			
(distance) (direction) (nearest town)			
WELL PURPOSE: Irrigation			
(home, irrigation, municipal, industrial)			
WELL COMPLETION DATA:			
(1) diameter (inches) 16"			
(2) total depth (feet) 107'			
(3) static water level (feet) 14' below top of ground.			
(4) casing Steel 57' (material) (depth)			
16" (size) if telescope see back.			
(5) screen 50' 107' (length) (depth to top)			
16" Steel (size) (material)			
(6) pump _____ (HP) _____ (yield gpm)			
(type power)			
(7) electric log No (yes or no)			
(organization running log)			
(8) how well bottom plugged Plate			
DRILLERS REMARKS:			
Purchaser's pumping equipment to be used.			

CODED


RECEIVED

JUN 26 1974

ATER COM

If well telescopes please sketch and show depths.

GROUND LEVEL

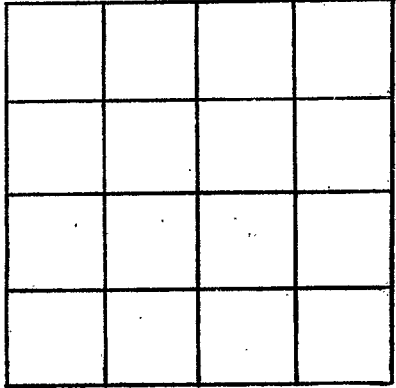

SECTION _____

Please indicate well location X.

ADDITIONAL INFORMATION

If more than one screen, show locations of each on sketch.