

MISSISSIPPI BOARD OF WATER COMMISSIONERS

SUNF.


D 7 41
9-10-62

WATER WELL DRILLERS LOG

D-007 (3)

Date: AUG 10, 1962, Driller: DELTA DRILLING CO. County: SUNFLOWER
(Name)

	Description & Color of Materials Sand, Clay, Red Clay, Shell, etc.	Thick- ness Feet	Depth Feet
(1) Owner of Land: <u>J. C. HANEY</u> (Name)	SAND	65	65
<u>DREW, MISS.</u> (Address)	GRAVEL	46	111
(2) Location: <u>SW 1/4, NW 1/4, Sec. 23 T23N R3-W</u>	SHALE	60	171
_____ miles _____ of _____ (distance) (direction) (Nearest Town)	SAND	65	236
(3) Topography: _____ (Hilly) (Flat) (Level)	SHALE	17	253
(4) Purpose of Well: <u>DOMESTIC</u> (Domestic Irrigation Municipal, Industrial, Other)	GUMBO	116	369
Information upon completion of well:	SAND	25	394
(1) Diameter <u>4</u> inches.	SHALE	10	495
(2) Total Depth <u>992</u> feet.	SAND	16	511
(3) Water Level <u>WELL FLOWS</u> feet below top of ground.	GUMBO	83	594
(4) Cased to <u>992</u> , Size <u>4 x 2"</u>	GREEN SAND w/ROCK	52	646
(5) Screen: Size <u>2"</u> , Length <u>20</u>	SHALE	80	726
(6) Were any formations sealed against pollution? _____ yes, _____ no.	GREEN SAND	60	786
If YES depth of formation _____	SHALE	70	856
Why _____	SAND	12	868
Drillers Remarks: <u>16' LAP OF 2" IN</u>	SHALE	36	904
<u>4" PIPE - 21' 2" TAIL PIPE</u>	WHITE SAND	67	971
<u>ON BOTTOM OF WELL - BOTTOM</u>	GUMBO	21	992
<u>OF 2" SCREEN SET 976'</u>			
<u>WELL FLOWS 20 TO 25 GPM</u>			

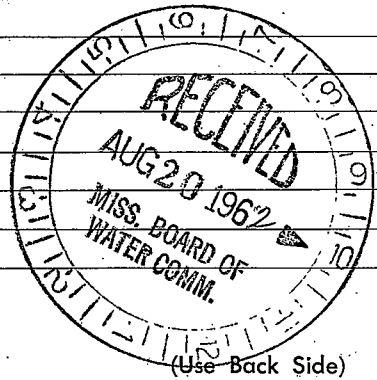

Well No.

