

Sunflower
D11
11/10/71

MISSISSIPPI
 BOARD OF WATER COMMISSIONERS
 416 North State Street
 Jackson, Mississippi 39201

CODED

WATER WELL DRILLERS LOG

11/10 date well completed 1971 John R. Braden firm name Jefferson county well located

LANDOWNER:

Miss J. R. McHale
P.O. Box - Drew, Miss.
 (mailing address)

description of formations encountered

from to

<u>Soft Soil</u>	<u>0</u>	<u>10</u>
<u>Gravel sand</u>	<u>10</u>	<u>35</u>
<u>Sand gravel</u>	<u>35</u>	<u>180</u>
<u>Clay</u>	<u>180</u>	<u>230</u>
<u>Clay</u>	<u>230</u>	<u>280</u>
<u>Clay with fine pebbles</u>	<u>280</u>	<u>500</u>
<u>Sand</u>	<u>500</u>	<u>530</u>
<u>Clay</u>	<u>530</u>	<u>598</u>
<u>Clay</u>	<u>598</u>	<u>599</u>
<u>Clay</u>	<u>599</u>	<u>1014</u>
<u>Sand</u>	<u>1014</u>	<u>1115</u>
<u>is shale</u>	<u>1115</u>	<u>129</u>
<u>Sand</u>	<u>129</u>	<u>132</u>
<u>Rock</u>	<u>132</u>	<u>133</u>
<u>Sand</u>	<u>133</u>	<u>1500</u>
<u>Shale & Rock</u>	<u>1500</u>	<u>150</u>
	<u>150</u>	<u>?</u>

WELL LOCATION:

sec. 24 T23 N R. 3 E
4 miles North of Drew
 (distance) (direction) (nearest town)

WELL PURPOSE: Home
 (home, irrigation, municipal, industrial)

WELL COMPLETION DATA:

- (1) diameter (inches) 4 X 2 1/2
- (2) total depth (feet) 672
- (3) static water level (feet) 24 below above top of ground.
- (4) casing Galv. steel (material) (depth)
- _____ if telescope see back. (size)
- (5) screen 20 (length) (depth to top)
21 Stainless steel (size) (material)
- (6) pump 1 (HP) 19 (yield gpm)
Blow (type power)
- (7) electric log No (yes or no)
- _____ (organization running log)
- (8) how well bottom plugged RT. Sealed

CODED


DRILLERS REMARKS:

John Braden

If well telescopes please sketch and show depths.

2

GROUND LEVEL

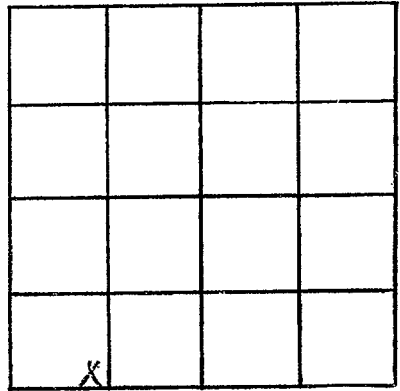

SECTION 24

Please indicate well location X.

ADDITIONAL INFORMATION

A series of horizontal lines for additional information.

If more than one screen, show locations of each on sketch.