

SUNFLOWER
D12
6-9-72

MISSISSIPPI
 BOARD OF WATER COMMISSIONERS
 416 North State Street
 Jackson, Mississippi 39201

CODED

WATER WELL DRILLERS LOG

6-9-1972 date well completed 1972 DIERWELLER firm name SUNFLOWER county well located

LANDOWNER:
 BROOKS GIN
 DREW, MISS.
 (mailing address)

description of formations encountered	from	to
CLAY	0	22
MURKY SAND	22	42
SAND & PEA GRAVEL	42	102

WELL LOCATION:
 sec. 28 T 23 N R 3
 1 1/2 miles N of DREW
 (distance) (direction) (nearest town)

WELL PURPOSE: INDUSTRIAL
 (home, irrigation, municipal, industrial)

- WELL COMPLETION DATA:
- (1) diameter (inches) 4"
 - (2) total depth (feet) 102 FT
 - (3) static water level (feet) 18' below top of ground.
 - (4) casing PLIC IR, 82' (material), (depth), 4" (size) if telescope see back.
 - (5) screen 20' 82' (length), (depth to top), 4" GALV. WIRE ON PIPE (size), (material)
 - (6) pump 5 85 (HP), (yield gpm)
 ELEC (type power)
 - (7) electric log No (yes or no)
 (organization running log)
 - (8) how well bottom plugged B.P.D.

CODED


JUN 19 1972

DRILLERS REMARKS:

NO. OF
 WATER

If well telescopes please sketch and show depths.

GROUND LEVEL

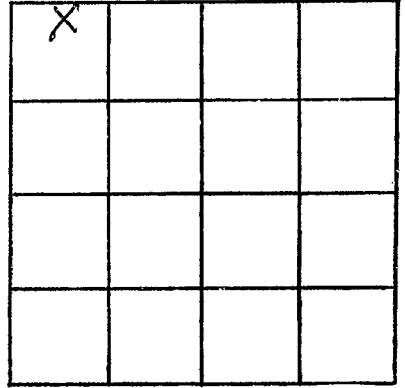

SECTION 28

Please indicate well location X.

ADDITIONAL INFORMATION

If more than one screen,
show locations of each on sketch.