

SUNFLOWER
D13
12-26-72

MISSISSIPPI
 BOARD OF WATER COMMISSIONERS
 416 North State Street
 Jackson, Mississippi 39201

CODE F

WATER WELL DRILLERS LOG

Dec 26 1972 Water Well Supply Sunflower
 date well completed firm name county well located

LANDOWNER:
W. H. Newton
Drew - Miss.
 (mailing address)

WELL LOCATION:
 sec 13 T 23 N R 4 W
4 miles North of Drew
 (distance) (direction) (nearest town)

WELL PURPOSE: Home
 (home, irrigation, municipal, industrial)

- WELL COMPLETION DATA:**
- (1) diameter (inches) 4 1/2
 - (2) total depth (feet) 850
 - (3) static water level (feet) 26 below above top of ground.
 - (4) casing gal steel
 (material) (depth)
 (size) if telescope see back.
 - (5) screen 20
 (length) (depth to top)
2 Standard steel
 (size) (material)
 - (6) pump 1 19
 (HP) (yield gpm)
slur
 (type power)
 - (7) electric log No
 (yes or no)
 (organization running log)
 - (8) how well bottom plugged BT



description of formations encountered	from	to
Top soil	0	23
Shale	23	83
Sand + gravel	83	163
Sand + clay	163	203
Clay	203	323
Sand	323	403
Clay	403	603
Gravel sand	603	663
Clay + rock	663	820
Shale	820	850

JAN 10 1973

DRILLERS REMARKS: 2

If well telescopes please sketch and show depths.

GROUND LEVEL

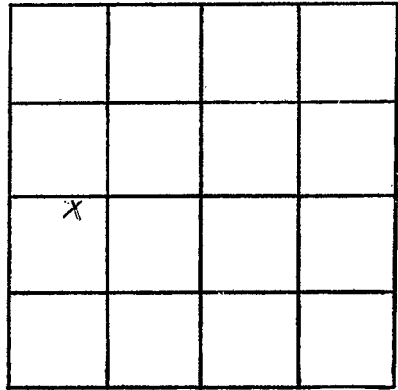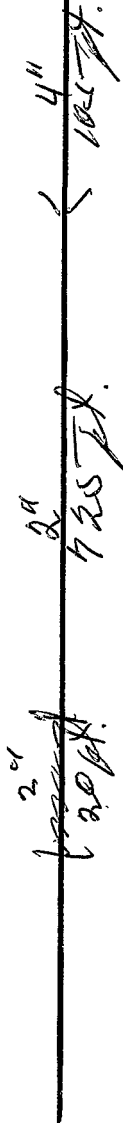

SECTION 23

Please indicate well location X.

ADDITIONAL INFORMATION

Lined area for additional information.

If more than one screen, show locations of each on sketch.