

**SUNFLOWER**  
**D 15**  
**7-20-73**

MISSISSIPPI  
 BOARD OF WATER COMMISSIONERS  
 416 North State Street  
 Jackson, Mississippi 39201

**CODED**

**WATER WELL DRILLERS LOG**

July 20 1973 Cleveland Drilling Sunflower  
 date well completed firm name county well located

LANDOWNER: H.P. Oliver  
10 new miss  
 (mailing address)

description of formations encountered	from	to
<u>Clay</u>	<u>Top</u>	<u>12'</u>
<u>Soft Gravel</u>	<u>12'</u>	<u>60'</u>
	<u>60'</u>	<u>100'</u>

WELL LOCATION:  
 sec. 23 T. 23 N R. 3 E  
8 miles N.E. of Drawmi  
 (distance) (direction) (nearest town)

WELL PURPOSE: Drain  
 (home, irrigation, municipal, industrial)

**CODED**

- WELL COMPLETION DATA:
- (1) diameter (inches) 4"
  - (2) total depth (feet) 100'
  - (3) static water level (feet) 22' below top of ground.
  - (4) casing Plastic, 80'  
 (material) (depth)  
 (size) if telescope see back.
  - (5) screen 20', 80'  
 (length) (depth to top)  
4", PVC Plastic  
 (size) (material)
  - (6) pump 2 HP, 80  
 (HP) (yield gpm)  
Oil  
 (type power)
  - (7) electric log             
 (yes or no)  
            
 (organization running log)
  - (8) how well bottom plugged Ev


DRILLERS REMARKS:           

**OCT 18 1973**

MISS. BOARD OF WATER COMMISSIONERS

If well telescopes please sketch and show depths.

GROUND LEVEL

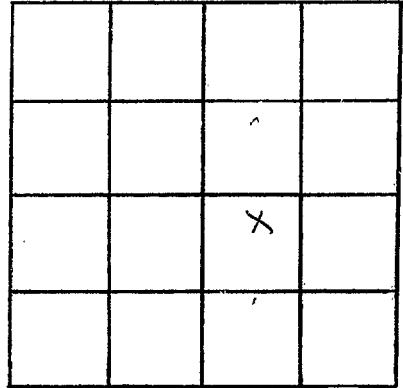

SECTION 23

Please indicate well location X.

ADDITIONAL INFORMATION

If more than one screen,  
show locations of each on sketch.