

SUNFLOWER

C17596

BOLIVAR
D 16
2-26-75

MISSISSIPPI
BOARD OF WATER COMMISSIONERS
416 North State Street
Jackson, Mississippi 39201

CODED

WATER WELL DRILLERS LOG

SUNFLOWER

February 26, 19 75 Singer-Layne Central Div. Bolivar
date well completed firm name county well located


LANDOWNER:	description of formations encountered	from	to
G. W. Moody			
Drew, MS	Clay	0	20
(mailing address)	Fine Sand Gravel	20	46
WELL LOCATION:	Coarse Sand Gravel	46	90
sec. 12 T 23 N R 3 W	Coarse Sand Gravel & Big Gravel	90	116
9 miles northeast of Drew	Boulder		116
(distance) (direction) (nearest town)			
WELL PURPOSE: Irrigation			
(home, irrigation, municipal, industrial)			
WELL COMPLETION DATA:			
(1) diameter (inches) 16"			
(2) total depth (feet) 116'			
(3) static water level (feet) 17 below top of ground			
(4) casing steel 66' (material) (depth)			
* 16" If telescope see back. (size)			
(5) screen 50' 66' (length) (depth to top)			
16" steel (size) (material)			
(6) pump 60 2400 (HP) (yield gpm)			
engine (type power)			
(7) electric log N/A (yes or no)			
(organization running log)			
(8) how well bottom plugged with plat			
DRILLERS REMARKS:			

CODED

DRILLER'S SIGNATURE
APR - 2 1975
MISS. BD. OF WATER COMMISSIONERS

If well telescopes please sketch and show depths.

GROUND LEVEL

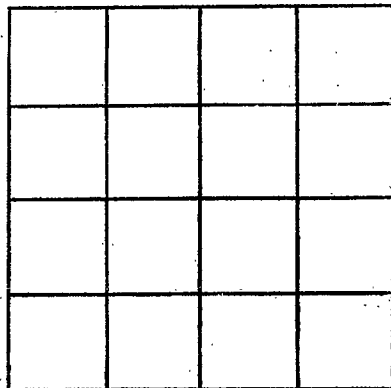

SECTION _____

Please indicate well location X.

ADDITIONAL INFORMATION

If more than one screen,
show locations of each on sketch.