

Sunflower
 D 47
 4-10-75


MISSISSIPPI
 BOARD OF WATER COMMISSIONERS
 416 North State Street
 Jackson, Mississippi 39201

CODED

WATER WELL DRILLERS LOG

Sengin - Kayne


April 10, 19 75 Wilton Hood Sunflower
 date well completed firm name county well located

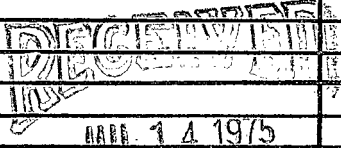LANDOWNER: Wilton Hood Drew, Miss.	description of formations encountered	from	to
(mailing address)	Clay	0	20'
WELL LOCATION:	Sandy Clay	20	30'
sec. 11 T 23 ^{15'} N R 3 E W 6 miles N East of Drew (distance) (direction) (nearest town)	Fine Sand	30	49'
WELL PURPOSE: irrigation (home, irrigation, municipal, industrial)	Coarse Sand	49	95'
WELL COMPLETION DATA:			
(1) diameter (inches) 16"			
(2) total depth (feet) 95'			
(3) static water level (feet) 13 below top of ground.			
(4) casing Steel, 55' (material) (depth) 16" (size) if telescope see back.			
(5) screen 40' (length), 40' (depth to top) 16" (size), Steel (material)			
(6) pump 70 (HP), 2,400 (yield gpm) engine (type power)			
(7) electric log no (yes or no)			
(organization running log)			
(8) how well bottom plugged steel plate			
DRILLERS REMARKS:	 APR 14 1975 MISS. BD. OF WATER COMMISSIONERS		

CODED

If well telescopes please sketch and show depths.

GROUND LEVEL

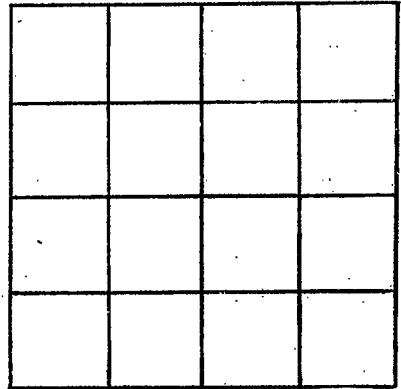

SECTION _____

Please indicate well location X.

ADDITIONAL INFORMATION

If more than one screen, show locations of each on sketch.