

CODED

MISSISSIPPI
BOARD OF WATER COMMISSIONERS
416 North State Street
Jackson, Mississippi 39201

WATER WELL DRILLERS LOG

SUNFLOWER
D 20
1-20-75

Jan. 20 1975 Dyer-Sullivan, Inc. Sunflower
date well completed firm name county well located

LANDOWNER: Bill Coleman

description of formations encountered

from to

Drew, Miss

Clay

0 25

(mailing address)

Fine Sand

25 76

SAND + GRAVEL

76 116

WELL LOCATION:

sec 26 T 23 N R 3 E 15A
2 1/2 miles NE of Drew
(distance) (direction) (nearest town)


WELL PURPOSE: Irrigation
(home, irrigation, municipal, industrial)

WELL COMPLETION DATA:

- (1) diameter (inches) 16"
- (2) total depth (feet) 116
- (3) static water level (feet) 14 below top of ground.
- (4) casing Blk Iron, 76' (material), (depth)
16" (size) if telescope see back.
- (5) screen 40' (length), 76' (depth to top)
16 (size), Blk Inset (material)
- (6) pump 600 (HP), 3000 (yield gpm)
Diesel (type power)
- (7) electric log NO (yes or no)

(organization running log)

(8) how well bottom plugged Flats

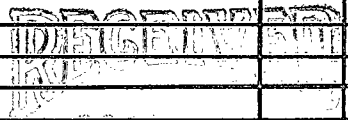


DRILLERS REMARKS:

JAN 18 1975

If well telescopes please sketch and show depths.

GROUND LEVEL

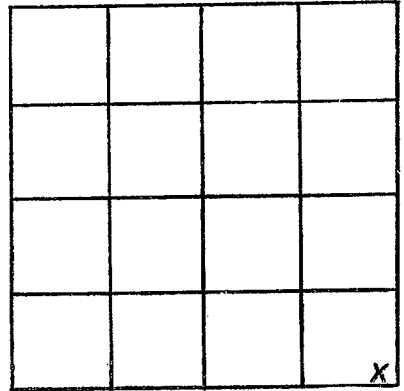

SECTION 24

Please indicate well location X.

ADDITIONAL INFORMATION

If more than one screen,
show locations of each on sketch.