

SUNFLOWER

D 23

2.12.77

MISSISSIPPI  
BOARD OF WATER COMMISSIONERS  
416 North State Street  
Jackson, Mississippi 39201

CODED

WATER WELL DRILLERS LOG

DYER-SULLIVAN, INC.

SUNFLOWER

2-12

19 77

date well completed

firm name

county well located

LANDOWNER: Rodolph Smith

Rome, Miss.

(mailing address)

description of formations encountered

from

to

CLAY

0

14

Fine Sand

14

28

Coarse Sand

28

42

Coarse Sand & Gravel

42

119

WELL LOCATION:

sec. 7 T. 23 N. R. 3 E  
S W  
2 miles NW of Rome  
(distance) (direction) (nearest town)

WELL PURPOSE: FA.  
(home, irrigation, municipal, industrial)

WELL COMPLETION DATA:

- (1) diameter (inches) 16"
- (2) total depth (feet) 119'
- (3) static water level (feet) 19 below above top of ground.
- (4) casing Steel 79'  
(material) (depth)  
16' if telescope see back.  
(size)
- (5) screen 40' 79'  
(length) (depth to top)  
16" Steel  
(size) (material)
- (6) pump 40 1800  
(HP) (yield gpm)  
Diesel  
(type power)
- (7) electric log No  
(yes or no)

(organization running log)

(8) how well bottom plugged PLATE

DRILLERS REMARKS:


CODED

RECEIVED  
MAR 18 1977

MISS. BD. OF WATER COMM.

If well telescopes please sketch and show depths.

GROUND LEVEL

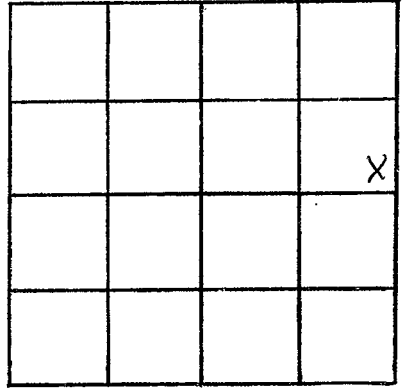

SECTION \_\_\_\_\_

Please indicate well location X.

ADDITIONAL INFORMATION

If more than one screen,  
show locations of each on sketch.