

Over North IR. Ser.

SUNFLOWER

D 30

9-25-68

MISSISSIPPI BOARD OF WATER COMMISSIONERS

416 North State Street

Jackson, Mississippi 39201

CODED

WATER WELL DRILLERS LOG

9-25 1968 date well completed

EARL SHYRDEN SUNFLOWER firm name county well located

LANDOWNER:

EARL SHYRDEN  
DREW, Miss.  
(mailing address)

description of formations encountered

from to

CLAY	0	13
FINE SAND	13	23
✓ ✓	23	33
✓ ✓	33	43
✓ ✓	43	53
MED. SAND	53	63
MED SAND SHOT WITH		
CLAY	63	73
FINE SAND	73	83
FINE SAND GRA.	83	93
C. SAND & GRA.	93	103
✓ ✓	103	113

WELL LOCATION:

sec 35 T 23 S R 3 E  
2 1/2 miles EAST of DREW  
(distance) (direction) (nearest town)


WELL PURPOSE:

TRP.  
(home, irrigation, municipal, industrial)

WELL COMPLETION DATA:

- (1) diameter (inches) 16"
- (2) total depth (feet) 113'
- (3) static water level (feet) 21' below top of ground
- (4) casing 16" (material) 73' (depth)
- (5) screen 40' 73' (length) (depth to top)  
16" B.V. IR. (size) (material)
- (6) pump 28 (HP) 1500 (yield gpm)  
DIESEL (type power)
- (7) electric log No (yes or no)
- (8) how well bottom plugged PLATE


CODED

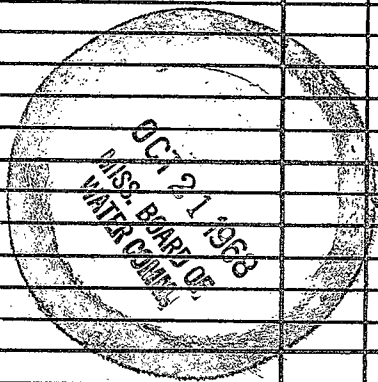

DRILLERS REMARKS:

If well telescopes please sketch and show depths.

GROUND LEVEL

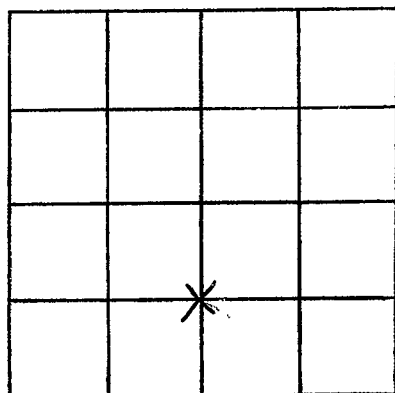

SECTION 35

Please indicate well location X.

ADDITIONAL INFORMATION

If more than one screen,  
show locations of each on sketch.