

Sunflower
 D 33
 4-7-70

MISSISSIPPI
 BOARD OF WATER COMMISSIONERS
 416 North State Street
 Jackson, Mississippi 39201
 WATER WELL DRILLERS LOG

4/23/70
 COPIED

C3133 Well #1

April 7, 1970 Layne-Central Company Sunflower
 date well completed firm name county well located

LANDOWNER: G. W. Moody
 Drew, Mississippi
 (mailing address)

description of formations encountered	from	to
Clay	0	18
Sand	18	30
Gravel, coarse sand	30	80
Coarse sand, sand, big boulders	80	101
Rock	101	

WELL LOCATION:
 sec. 12 T 23 N R 3 E W
 6 miles NE of Drew
 (distance) (direction) (nearest town)

WELL PURPOSE: irrigation
 (home, irrigation, municipal, industrial)

- WELL COMPLETION DATA:
- (1) diameter (inches) 16
 - (2) total depth (feet) 101
 - (3) static water level (feet) 32' below top of ground.
 - (4) casing Steel, 51' (material), (depth), 16" (size) if telescope see back.
 - (5) screen 50', 101' (length), (depth to top), 16", Armco (size), (material)
 - (6) pump 50 (HP), 2000 (yield gpm), engine (type power)
 - (7) electric log no (yes or no)
 (organization running log)
 - (8) how well bottom plugged plate

COPIED


APR 24 1970

MISS. BD. OF
 WATER COMM.

DRILLERS REMARKS:

If well telescopes please
sketch and show depths.

GROUND LEVEL

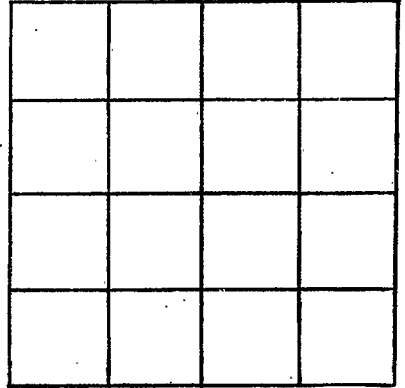

SECTION _____

Please indicate well location X.

ADDITIONAL INFORMATION

If more than one screen,
show locations of each on sketch.