

Sunflower
 D 34
 4-10-70

MISSISSIPPI
 BOARD OF WATER COMMISSIONERS
 416 North State Street
 Jackson, Mississippi 39201

4/22/70
 CODED
 83153 Well #2

WATER WELL DRILLERS LOG

April 10, 1970 Layne-Central Company Sunflower
 date well completed firm name county well located


LANDOWNER:	description of formations encountered		from	to
G. W. Moody	Clay		0	18
	Sand		18	35
Drew, Mississippi	Gravel		35	80
(mailing address)	Sand and boulders		80	101
	Rock		105	
WELL LOCATION:				
sec. 12 T-23N R-3E S-3W				
6 miles NE of Drew				
(distance) (direction) (nearest town)				
WELL PURPOSE: irrigation				
(home, irrigation, municipal, industrial)				
WELL COMPLETION DATA:				
(1) diameter (inches) 16				
(2) total depth (feet) 105				
(3) static water level (feet) 14' below surface top of ground.				
(4) casing steel 55' (material) (depth)				
16" (size) if telescope see back.				
(5) screen 50' 105' (length) (depth to top)				
16" (size) Armco (material)				
(6) pump 50 2000 (HP) (yield gpm)				
engine (type power)				
(7) electric log no (yes or no)				
(organization running log)				
(8) how well bottom plugged plate				
DRILLERS REMARKS:				

APR 24 1970

MISS. Bd. OF WATER COMM.

If well telescopes please sketch and show depths.

GROUND LEVEL

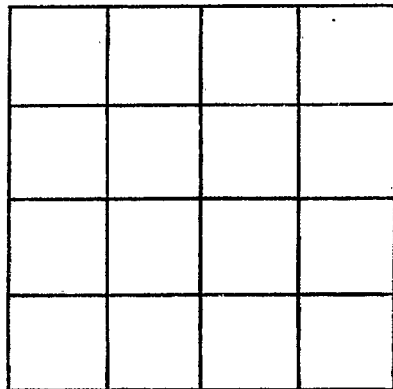

SECTION _____

Please indicate well location X.

ADDITIONAL INFORMATION

If more than one screen,
show locations of each on sketch.