

Sunflower
D.35
6-11-69

MISSISSIPPI
BOARD OF WATER COMMISSIONERS
416 North State Street
Jackson, Mississippi 39201

CODED

WATER WELL DRILLERS LOG

6-11-69 19 **DYER WELL & IRRIGATION SERVICE** **SUNFLOWER**
date well completed firm name county well located

LANDOWNER:
H.T. MILLER PT. Co

description of formations encountered

DREW, MISS.
(mailing address)

description of formations encountered	from	to
Clay	0	13
Brown Sand	13	73
Coarse Sand	73	33
Fine Sand	33	43
Coarse Sand	43	53
Blue Clay Fine Sand	53	63
Fine Sand	63	73
Clay Sand + Gravel	73	83
Coarse Sand Gravel	83	93
	93	103
	103	113
	113	113

WELL LOCATION:
sec 27 T 23 N R 3 W
3 miles EAST of DREW
(distance) (direction) (nearest town)

WELL PURPOSE: IRRIGATION
(home, irrigation, municipal, industrial)

WELL COMPLETION DATA:

- (1) diameter (inches) 12"
- (2) total depth (feet) 129'
- (3) static water level (feet) 21' below top of ground.
- (4) casing BUC INGOT 83'
(material) (depth)
12" If telescope see back.
(size)
- (5) screen 40' 83'
(length) (depth to top)
12" BUC INGOT
(size) (material)
- (6) pump 28 1650
(HP) (yield gpm)
TRACTOR
(type power)
- (7) electric log No
(yes or no)
(organization running log)
- (8) how well bottom plugged PLATE

CODED


JUL 23 1969

DRILLERS REMARKS:

MISS. BD. OF
WATER COMM.

If well telescopes please
sketch and show depths.

GROUND LEVEL

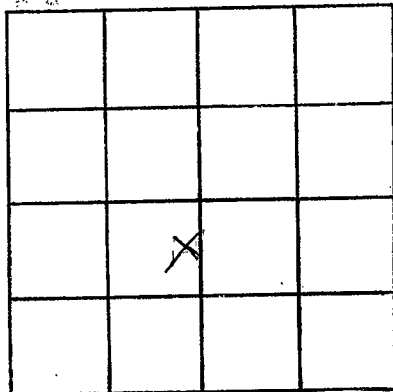

SECTION 27

Please indicate well location X.

ADDITIONAL INFORMATION

If more than one screen,
show locations of each on sketch.