

**SUNFLOWER**  
**D37**  
**4-13-74**

**MISSISSIPPI  
 BOARD OF WATER COMMISSIONERS**  
 416 North State Street  
 Jackson, Mississippi 39201

**WATER WELL DRILLERS LOG**

APRIL 15 1974 EVER WELL & IRRIGATION SERVICE SADFLOWER  
 date well completed firm name county well located

<b>LANDOWNER:</b> <u>Train Parker Jr.</u>	description of formations encountered	from	to
<u>DREW, WIEV,</u> (mailing address)			
<b>WELL LOCATION:</b> sec. <u>13</u> T. <u>23</u> N R. <u>3</u> W <u>5</u> miles <u>N.E.</u> of <u>DREW</u> (distance) (direction) (nearest town)	<u>SAND</u>	<u>17</u>	<u>41</u>
<b>WELL PURPOSE:</b> <u>IRR.</u> (home, irrigation, municipal, industrial)	<u>SAND &amp; GRAVEL</u>	<u>41</u>	<u>103</u>
<b>WELL COMPLETION DATA:</b>			
(1) diameter (inches) <u>16"</u>			
(2) total depth (feet) <u>103'</u>			
(3) static water level (feet) <u>17'</u> below top of ground.			
(4) casing <u>BURTR</u> <u>63'</u> (material) (depth)			
<u>16"</u> if telescope see back. (size)			
(5) screen <u>40'</u> <u>63'</u> (length) (depth to top)			
<u>16"</u> <u>BURTR</u> (size) (material)			
(6) pump <u>60</u> <u>3000</u> (HP) (yield gpm)			
<u>DIESEL</u> (type power)			
(7) electric log <u>N/O</u> (yes or no)			
(organization running log)			
(8) how well bottom plugged <u>PLATE</u>			
<b>DRILLERS REMARKS:</b>			

*CLAYED*

*PLATE*


**RECORDED**  
**INDEXED**

**NOV 21 1974**

**MISS. RD. OF WATER COMMISSIONERS**

If well telescopes please  
sketch and show depths.

GROUND LEVEL

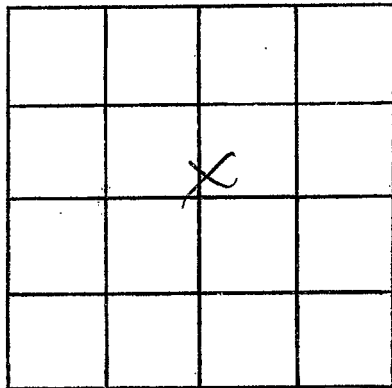

SECTION 13

Please indicate well location X.

ADDITIONAL INFORMATION

If more than one screen,  
show locations of each on sketch.