


SUNFLOWER
D 38
4-2-75

MISSISSIPPI
BOARD OF WATER COMMISSIONERS
416 North State Street
Jackson, Mississippi 39201

CODED


WATER WELL DRILLERS LOG

April 2, 1975 Singer-Layne Central Viv. Sunflower
date well completed firm name county well located

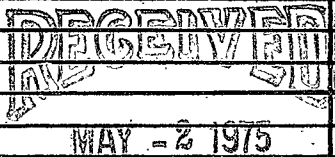LANDOWNER:	description of formations encountered	from	to
Wilton Hood Drew, Miss. (mailing address)	Clay	0	14
	Brown Sand	14	25
	Fine Sand	25	51
WELL LOCATION:	Coarse Sand & Pea Gravel	51	59
sec. 12 T 23 N R 3 W	Coarse Sand & Gravel	59	96
4 miles northeast of Drew (distance) (direction) (nearest town)	Coarse Sand & Big Gravel	96	106
WELL PURPOSE: irrigation (home, irrigation, municipal, industrial)			
WELL COMPLETION DATA:			
(1) diameter (inches) 16"			
(2) total depth (feet) 106'			
(3) static water level (feet) 18 below top of ground.			
(4) casing steel 56' (material) (depth) 16" If telescope see back. (size)			
(5) screen 50' 56' (length) (depth to top)			
16" steel (size) (material)			
(6) pump 40 2400 (HP) (yield gpm)			
engine (type power)			
(7) electric log NO (yes or no)			
(organization running log)			
(8) how well bottom plugged with plate			
DRILLERS REMARKS:			

If well telescopes please sketch and show depths.

GROUND LEVEL

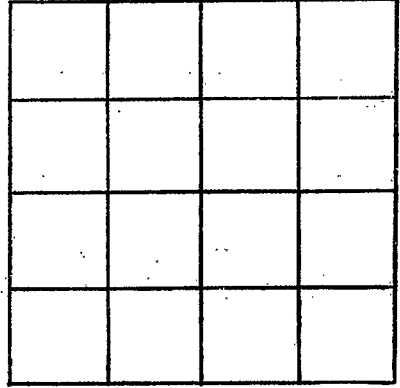

SECTION _____

Please indicate well location X.

ADDITIONAL INFORMATION

If more than one screen,
show locations of each on sketch.