

SUNFLOWER
D 39
4-12-75

MISSISSIPPI
BOARD OF WATER COMMISSIONERS
 416 North State Street
 Jackson, Mississippi 39201

CODED

WATER WELL DRILLERS LOG


April 12, 1975 Singer-Layne Central Div. Sunflower
 date well completed firm name county well located

LANDOWNER:	description of formations encountered	from	to
C. W. Capps, Jr. Cleveland, MS (mailing address)			
WELL LOCATION: sec. 29 T 23 N R 3 W 4 miles northwest of Drew (distance) (direction) (nearest town)	Brown Sand	3	25
	Fine Sand	25	49
	Coarse Sand	49	70
	Coarse Sand & Pea Gravel	70	89
	Coarse Sand & Gravel	89	96
	Coarse Sand & Boulders	96	99
WELL PURPOSE: irrigation (home, irrigation, municipal, industrial)			
WELL COMPLETION DATA: (1) diameter (inches) 12" (2) total depth (feet) 99' (3) static water level (feet) 17 below top of ground. (4) casing steel 53' (material) (depth) 12" (size) If telescope see back. (5) screen 46' 53' (length) (depth to top) 12" steel (size) (material) (6) pump 60 2800 (HP) (yield gpm) engine (type power) (7) electric log no (yes or no) (organization running log) (8) how well bottom plugged with plate			
DRILLERS REMARKS:			

RECEIVED
MAY - 5 1975
 MISS. BD. OF WATER COMM

If well telescopes please sketch and show depths.

GROUND LEVEL

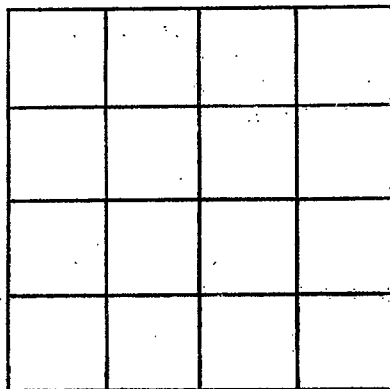

SECTION _____

Please indicate well location X.

ADDITIONAL INFORMATION

If more than one screen, show locations of each on sketch.