

SUNFLOWER  
D42  
3/30/78

MISSISSIPPI  
BOARD OF WATER COMMISSIONERS  
416 North State Street  
Jackson, Mississippi 39201

CODED

WATER WELL DRILLERS LOG  
BUTANE GAS COMPANY

3/30/78 19  
date well completed

OF GREENWOOD  
well name

Sunflower  
county well located


LANDOWNER:	description of formations encountered	from	to
Buford Plantation Glen Lora (mailing address)	Clay Sand	0	20
WELL LOCATION: sec. 21 T. 23 N R. 3 E 3 miles NE of Drew (distance) (direction) (nearest town)	SAND + Pea GRAVEL SAND + GRAVEL	20 30 60	30 60 100
WELL PURPOSE: IRR (home, irrigation, municipal, industrial)			
WELL COMPLETION DATA: (1) diameter (inches) 16" (2) total depth (feet) 100 (3) static water level (feet) 17 below above top of ground. (4) casing Steel, 60, (material) (depth) 16" (size) if telescope see back. (5) screen 40, 60 (length) (depth to top) 16" Steel (size) (material) (6) pump 60, 2500 (HP) (yield gpm) Diesel (type power) (7) electric log NO (yes or no) (organization running log)			
DRILLERS REMARKS: Steel Plate			

RECEIVED  
APR - 6 1978

MISS. BO. OF WATER COMMISSIONERS

If well telescopes please sketch and show depths.

GROUND LEVEL

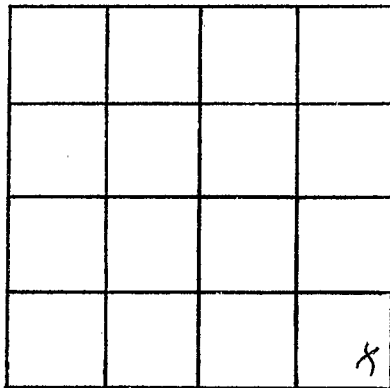

SECTION \_\_\_\_\_

Please indicate well location X.

ADDITIONAL INFORMATION

If more than one screen,  
show locations of each on sketch.