

SUNFLOWER
 D 44
 4/10/78

MISSISSIPPI
 BOARD OF WATER COMMISSIONERS
 416 North State Street
 Jackson, Mississippi 39201

CODED

WATER WELL DRILLERS LOG

April 10, 1978 Drew Well & Irrigation Sunflower
 date well completed firm name county well located

LANDOWNER: Billy Cummins
Leased - PARENMAN
Drew, Miss.
 (mailing address)

WELL LOCATION:
 sec. 9 T 23 N R 2 E
6 miles North of Drew
 (distance) (direction) (nearest town)

WELL PURPOSE: irrigation
 (home, irrigation, municipal, industrial)

- WELL COMPLETION DATA:
- (1) diameter (inches) 16¹¹
 - (2) total depth (feet) 113¹
 - (3) static water level (feet) 18¹ below above top of ground.
 - (4) casing Steel, 73¹
 (material) (depth)
 - 16⁰⁰ If telescope see back.
 (size)
 - (5) screen 40¹, 73¹
 (length) (depth to top)
 - 16⁰⁰, Steel
 (size) (material)
 - (6) pump 60 3,000
 (HP) (yield gpm)
 - Diesel
 (type power)
 - (7) electric log no
 (yes or no)

(organization running log)

(8) how well bottom plugged Plate

DRILLERS REMARKS:

description of formations encountered	from	to
Clay	0	13
Clay	14	23
Clay	24	33
Fine Sand	34	43
Fine Sand + Gravel	44	53
Fine Sand + Gravel	54	63
Fine Sand + Gravel	64	73
Sand + Gravel	74	113

Bottom 113¹
~~CODED~~


Miss. Board of Water Comm.

FEB 8 1979

RECEIVED

If well telescopes please sketch and show depths.

GROUND LEVEL

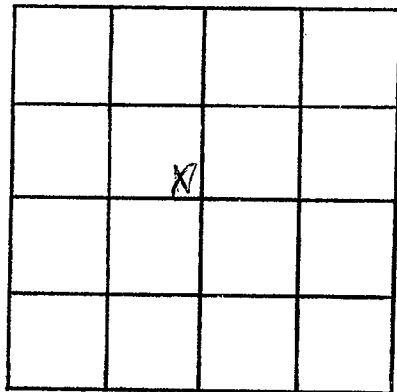

SECTION 9

Please indicate well location X.

ADDITIONAL INFORMATION

A series of horizontal lines for writing additional information.

If more than one screen, show locations of each on sketch.