

SUNFLOWER  
D 45  
2/28/78

MISSISSIPPI  
BOARD OF WATER COMMISSIONERS  
416 North State Street  
Jackson, Mississippi 39201

CODED

WATER WELL DRILLERS LOG

February 28 1978 Dyer Well + Irrigation Sunflower  
date well completed firm name county well located

LANDOWNER: Sixteenth Section!  
LAND-LEASED by Doyle Neal.  
(mailing address)

WELL LOCATION:  
sec. 16 T-23 N R-3 E  
S W  
5 miles North of Drew  
(distance) (direction) (nearest town)

WELL PURPOSE: Irrigation  
(home, irrigation, municipal, industrial)

- WELL COMPLETION DATA:
- (1) diameter (inches) 16"
  - (2) total depth (feet) 113'
  - (3) static water level (feet) 18' below top of ground.
  - (4) casing Steel 73' (material) (depth)  
16" (size) If telescope see back.
  - (5) screen 40' 73' (length) (depth to top)  
16" Steel (size) (material)
  - (6) pump 600 3000 (HP) (yield gpm)  
Diesel (type power)
  - (7) electric log No (yes or no)
  - (organization running log)
  - (8) how well bottom plugged Plate

description of formations encountered	from	to
Clay	0	13
Clay	14	23
Clay	24	30
FINE SAND	31	58
SAND + GRAVEL	59	113
Bottom	113	

CODED

Miss. Board of Water Comm.


FEB 8 1978

RECEIVED

DRILLERS REMARKS:

If well telescopes please sketch and show depths.

GROUND LEVEL

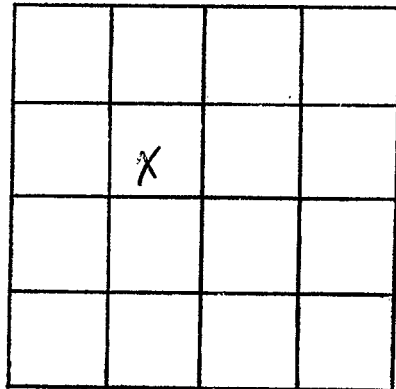

SECTION 16

Please indicate well location X.

ADDITIONAL INFORMATION

If more than one screen,  
show locations of each on sketch.