

Sunflower  
D-47  
10/3/79  
10/3

MISSISSIPPI  
BOARD OF WATER COMMISSIONERS  
416 North State Street  
Jackson, Mississippi 39201

WATER WELL DRILLERS LOG

CODED

date well completed

firm name

county well located

1979 DYER WELL

SUNFLOWER

LANDOWNER:	description of formations encountered	from	to
H.T. MILLER DREW (mailing address)			
WELL LOCATION: sec. <u>24</u> T <u>23</u> S R <u>3</u> E W			
(distance) miles (direction) of (nearest town)			
WELL PURPOSE: (home, irrigation, municipal, industrial)			
WELL COMPLETION DATA:			
(1) diameter (inches) <u>12"</u>			
(2) total depth (feet) <u>100</u>			
(3) static water level (feet) <u>19</u> below top of ground.			
(4) casing <u>12"</u> (material) <u>60</u> (depth)			
<u>12</u> (size) if telescope see back.			
(5) screen <u>40'</u> (length) <u>60</u> (depth to top)			
<u>12</u> (size) <u>STEEL</u> (material)			
(6) pump <u>40</u> (HP) <u>1800</u> (yield gpm)			
<u>DIESEL</u> (type power)			
(7) electric log <u>NO</u> (yes or no)			
(organization running log)			
(8) how well bottom plugged <u>PLATE</u>			
DRILLERS REMARKS:			

CODED


DEPT. OF NATURAL RESOURCES  
BUREAU OF LAND & WATER RESOURCES

JAN 16 1980

RECEIVED

If well telescopes please sketch and show depths.

GROUND LEVEL

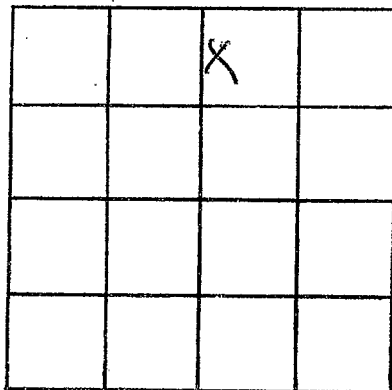

SECTION 24

Please indicate well location X.

ADDITIONAL INFORMATION

A series of horizontal lines for recording additional information.

If more than one screen, show locations of each on sketch.