

MISSISSIPPI DEPARTMENT OF NATURAL RESOURCES

Bureau of Land and Water Resources

Southport Mall

P.O. Box 10631

Jackson, Mississippi 39209

WATER WELL DRILLERS LOG

CODED

SUNFLOWER

D 49

9-16-80

9/16 1980 DYER WELL + IRR SUNFLOWER
 date well completed firm name county well located

LANDOWNER:

PARKER PLANTING CO.
 P.O. BOX 307

description of formations encountered

from

to

DREW MISS 38737
 (mailing address)

CLAY

0

40

SAND

40

45

SAND + GRAVEL

40

106

WELL LOCATION:

sec. 13 T. 23 N. R. 3 E
 S (W)
 4 1/2 miles NE of DREW
 (distance) (direction) (nearest town)

WELL PURPOSE:

(home, irrigation, municipal, industrial)

CODED

WELL COMPLETION DATA:

- (1) diameter (inches) 16
- (2) total depth (feet) 106
- (3) static water level (feet) 17 below above top of ground.
- (4) casing STEEL 66 (material) (depth)
 16 (size) If telescope see back.
- (5) screen 40 66 (length) (depth to top)
 16 STEEL (size) (material)
- (6) pump 60 3000 (HP) (yield gpm)
 DIESEL (type power)
- (7) electric log No (yes or no)

(organization running log)


- (8) how well bottom plugged STEEL PLATE

DRILLERS REMARKS:

DEPT. OF NATURAL RESOURCES
 BUREAU OF LAND AND WATER RESOURCES
 RECEIVED
 OCT 7 1980

If well telescopes please sketch and show depths.

GROUND LEVEL

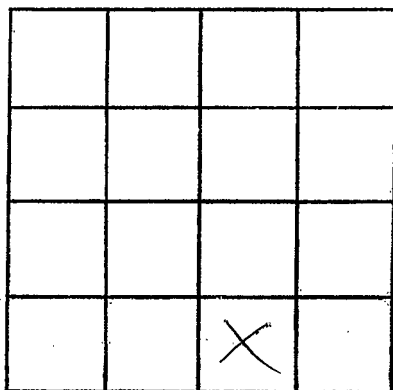

SECTION 13

Please indicate well location X.

ADDITIONAL INFORMATION

If more than one screen, show locations of each on sketch.