

SUNFLOWER  
 D 52  
 5-12-81

MISSISSIPPI DEPARTMENT OF NATURAL RESOURCES  
 Bureau of Land and Water Resources  
 Southport Mall  
 P.O. Box 10631  
 Jackson, Mississippi 39209  
 WATER WELL DRILLERS LOG

**CODED**

5-12-81 19 Superwell Corp Sunflower  
 date well completed firm name county well located

LANDOWNER: Mat Land  
 (mailing address)

| description of formations encountered | from      | to         |
|---------------------------------------|-----------|------------|
| <u>Clay</u>                           | <u>0</u>  | <u>20</u>  |
| <u>Fine Sand</u>                      | <u>20</u> | <u>38</u>  |
| <u>Sand</u>                           | <u>38</u> | <u>48</u>  |
| <u>Sand + Gravel</u>                  | <u>48</u> | <u>113</u> |

WELL LOCATION:  
 sec. 11 T 23 (N) R 3 E (W)  
6 miles NE of Drew  
 (distance) (direction) (nearest town)

**CODED**

WELL PURPOSE:  
 (home, irrigation, municipal, industrial)

- WELL COMPLETION DATA:
- (1) diameter (inches) 16
  - (2) total depth (feet) 113'
  - (3) static water level (feet) 21' below above top of ground.
  - (4) casing Steel, 113'  
 (material) (depth)  
16" if telescope see back.  
 (size)
  - (5) screen 40', 73'  
 (length) (depth to top)  
16", Steel  
 (size) (material)
  - (6) pump 60 3000  
 (HP) (yield gpm)  
Diesel  
 (type power)
  - (7) electric log \_\_\_\_\_  
 (yes or no)  
 \_\_\_\_\_  
 (organization running log)
  - (8) how well bottom plugged plate


DRILLERS REMARKS:

DEPT. OF NATURAL RESOURCES  
 BUREAU OF LAND & WATER RESOURCES

MAY 19 1981  
**RECEIVED**

If well telescopes please sketch and show depths.

GROUND LEVEL

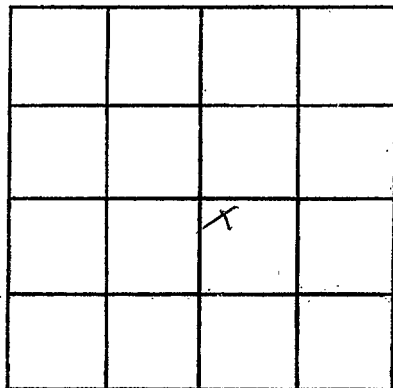

SECTION 11

Please indicate well location X.

ADDITIONAL INFORMATION

If more than one screen, show locations of each on sketch.