

MISSISSIPPI DEPARTMENT OF NATURAL RESOURCES

Bureau of Land and Water Resources

Southport Mall

P.O. Box 10631

Jackson, Mississippi 39209

WATER WELL DRILLERS LOG

CODED

SUNFLOWER
D 53
5-13-81

5-13-81 19 *Dyersville & Irig Sunflower*
date well completed firm name county well located

LANDOWNER: *Ted Recker*
Drew, MS.
(mailing address)

description of formations encountered	from	to
<i>clay</i>	<i>0</i>	<i>18</i>
<i>fine sand</i>	<i>18</i>	<i>30</i>
<i>sand</i>	<i>30</i>	<i>68</i>
<i>sand & gravel</i>	<i>68</i>	<i>113</i>

WELL LOCATION:
sec. *19* T *23* N R *30* E
3 miles *N* of *Drew*
(distance) (direction) (nearest town)

CODED

WELL PURPOSE:
(home, irrigation, municipal, industrial)

WELL COMPLETION DATA:

(1) diameter (inches) *16"*

(2) total depth (feet) *113*

(3) static water level (feet) *20'* below top of ground.

(4) casing *steel*, *113'*
(material) (depth)
16" if telescope see back.
(size)

(5) screen *40'* *73'*
(length) (depth to top)
16" *steel*
(size) (material)

(6) pump *60* *3000*
(HP) (yield gpm)
propane
(type power)

(7) electric log _____
(yes or no)

(organization running log)

(8) how well bottom plugged *plate*


DRILLERS REMARKS:

DEPT. OF NATURAL RESOURCES
BUREAU OF LAND & WATER RESOURCES

MAY 19 1981
RECEIVED

If well telescopes please sketch and show depths.

GROUND LEVEL

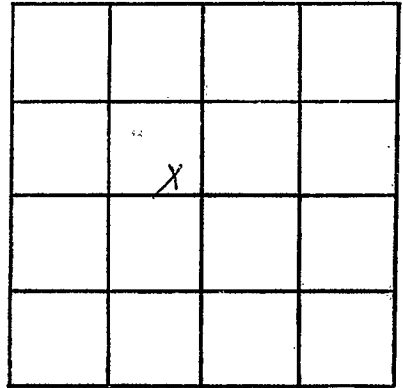

SECTION 19

Please indicate well location X.

ADDITIONAL INFORMATION

If more than one screen, show locations of each on sketch.