

MISSISSIPPI DEPARTMENT OF NATURAL RESOURCES

Bureau of Land and Water Resources

Southport Mall

P.O. Box 10631

Jackson, Mississippi 39209

WATER WELL DRILLERS LOG **CODED**

Sunflower

D54

2-26-81

0097

2/26

1981

Dyer

Sum.

date well completed

firm name

county well located

LANDOWNER:

BILL MANNING

Drew, MS.

(mailing address)

WELL LOCATION:

sec. 35 T 23 S R 3 E  
 3 miles E of Drew  
 (distance) (direction) (nearest town)

WELL PURPOSE:

(home, irrigation, municipal, industrial)

WELL COMPLETION DATA:


- (1) diameter (inches) 16
- (2) total depth (feet) 112'
- (3) static water level (feet) 22' below above top of ground.
- (4) casing Steel, 112',  
 (material) (depth)  
16" if telescopic see back.  
 (size)
- (5) screen 40', 72'  
 (length) (depth to top)  
16" (size) Steel (material)
- (6) pump 60, 3000  
 (HP) (yield gpm)  
Diesel  
 (type power)
- (7) electric log         
 (yes or no)  
 (organization running log)
- (8) how well bottom plugged plate

description of formations encountered


from to

sand	23	33
sand	33	43
sand	43	53
sand gravel	53	63
sand gravel	63	73
sand gravel	73	83
sand gravel	83	93
gravel	93	103
sand gravel	103	112

CODED

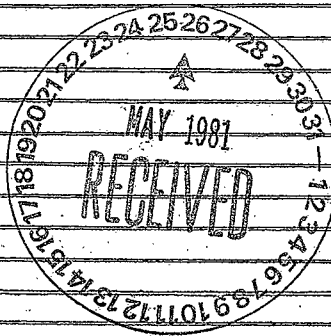

DRILLERS REMARKS:

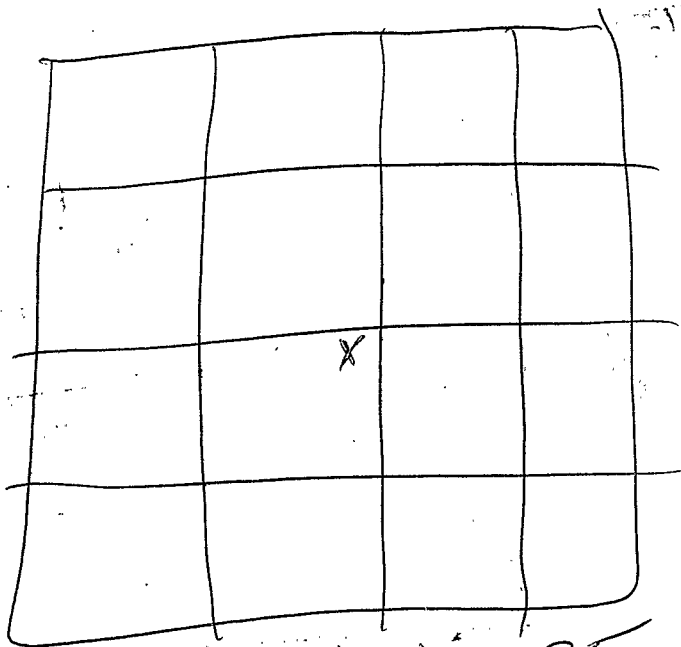

See 35