

MISSISSIPPI DEPARTMENT OF NATURAL RESOURCES

Bureau of Land and Water Resources

Southport Mall

P.O. Box 10631

Jackson, Mississippi 39209

WATER WELL DRILLERS LOG CODED

0098

Sun Flower  
D 55  
2-25-81

2/25 1981  
date well completed

Dyer  
driller name

Seem.  
county well located

LANDOWNER:  
**MIKE ELLIS**  
**Drew MS.**  
(mailing address)

description of formations encountered	from	to
Clay	23	33
Clay	33	43
Clay	43	53
sand & gravel	53	63
sand & gravel	63	73
sand & gravel	73	83
gravel	83	93
gravel	93	103

WELL LOCATION:  
sec 36 T 230 N R 3  
4 miles E of Drew  
(distance) (direction) (nearest town)

WELL PURPOSE:  
(home, irrigation, municipal, industrial)

CODED

WELL COMPLETION DATA:

(1) diameter (inches) 12"

(2) total depth (foot) 103'

(3) static water level (foot) 22' below above top of ground.


(4) casing Steel, 103'  
(material) (depth)  
12" if telescope case back.  
(size)

(5) screen 40', 63'  
(length) (depth, to top)  
12", Steel  
(size) (material)


(6) pump 40 2000  
(HP) (yield gpm)  
propare  
(type power)

(7) electric log \_\_\_\_\_  
(yes or no)  
  
(organization running log)

(8) how well bottom plugged plate

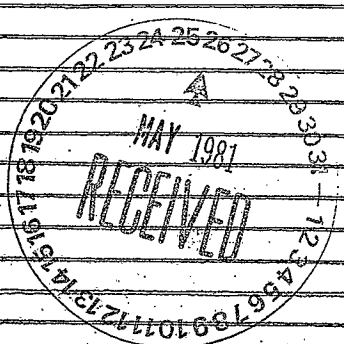

DRILLERS REMARKS:

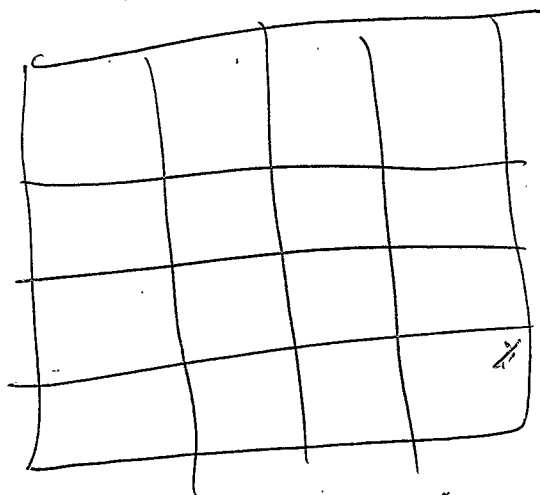

See 36