

Sunflower  
D57  
5-9-80

MISSISSIPPI  
BOARD OF WATER COMMISSIONERS  
416 North State Street  
Jackson, Mississippi 39201

CODED

WATER WELL DRILLERS LOG

5/9 1980 *Dye* *Sum.*  
date well completed firm name county well located

LANDOWNER:  
RIVER BEND PLANTING CO  
RED PARKER  
DREW, MS  
(mailing address)


description of formations encountered	from	to
Clay	0	28
fine sand	28	38
sand	38	48
fine gravel	48	113

WELL LOCATION:  
sec. 13 T. 23 N. R. 3 E.  
S  
7 miles NE of Drew  
(distance) (direction) (nearest town)

WELL PURPOSE:  
(home, irrigation, municipal, industrial)

- WELL COMPLETION DATA:
- (1) diameter (inches) 16"
  - (2) total depth (feet) 113'
  - (3) static water level (feet) 22' below top of ground.
  - (4) casing Steel 113' (material) (depth)  
76" If telescope see back. (size)
  - (5) screen 40' 73' (length) (depth to top)  
16" Steel (size) (material)
  - (6) pump 60 3000 (HP) (yield gpm)  
Diesel (type power)
  - (7) electric log (yes or no)  
(organization running log)
  - (8) how well bottom plugged *plate*


CODED

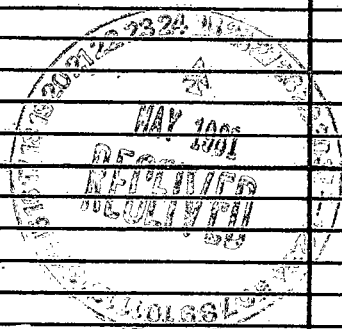

DRILLERS REMARKS:

If well telescopes please sketch and show depths.

GROUND LEVEL

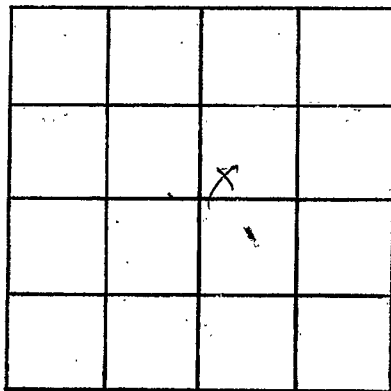

SECTION 13

Please indicate well location X.

ADDITIONAL INFORMATION

If more than one screen, show locations of each on sketch.