

Bureau of Land and Water Resources

Southport Mall

P.O. Box 10631

Jackson, Mississippi 39209

WATER WELL DRILLERS LOG

3341

CODED

Sunflower
D 58
11-20-80

11/20 1980
date well completed

Dyer
firm name

Sunflower
county well located

LANDOWNER:
C. E. WA. DRUY
Drew, MS.
(mailing address)

description of formations encountered	from	to
<u>Clay</u>	<u>0</u>	<u>28</u>
<u>fine sand</u>	<u>28</u>	<u>38</u>
<u>sand</u>	<u>38</u>	<u>48</u>
<u>Gravel & gravel</u>	<u>48</u>	<u>106</u>

WELL LOCATION:
sec. 23 T. 23 N. R. 3 E. S. 5
5 miles NE of Drew
(distance) (direction) (nearest town)

WELL PURPOSE:
(home, irrigation, municipal, industrial)

WELL COMPLETION DATA:

(1) diameter (inches) 16"

(2) total depth (feet) 106'

(3) static water level (feet) 20' below top of ground.

(4) casing Steel 106'
(material) (depth)
16" if telescopic see back.
(size)

(5) screen 40' 66'
(length) (depth to top)
16" Steel
(size) (material)

(6) pump 60 3000
(HP) (yield gpm)
Diesel
(type power)


(7) electric log _____
(yes or no)
(organization running log)

(8) how well bottom plugged plate

CODED



DRILLERS REMARKS:

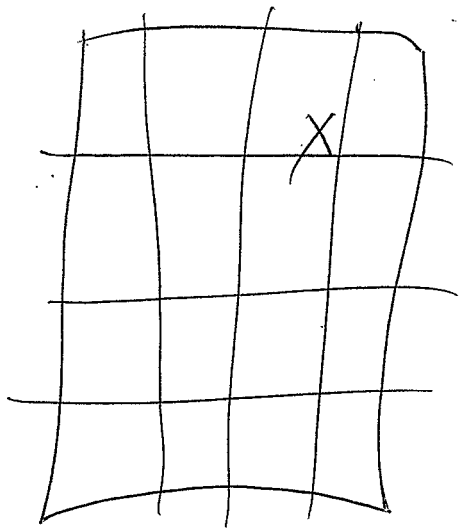

Sec 23