

MISSISSIPPI DEPARTMENT OF NATURAL RESOURCES

Bureau of Land and Water Resources

Southport Mall

P.O. Box 10631

Jackson, Mississippi - 39209

WATER WELL DRILLERS LOG

SUNFLOWER
D 59
8-15-81

8-15 1981 DYER WELL SUNFLOWER **CODED**
 date well completed firm name county well located

LANDOWNER: Charles Jackson
W. E. AUSTIN

INDIANOLA MISS
 (mailing address)

WELL LOCATION:
 sec. 1 T. 23 N. R. 3 E. W
4 miles E of Parchman
 (distance) (direction) (nearest town)

WELL PURPOSE:
 (home, irrigation, municipal, industrial)

WELL COMPLETION DATA:

- (1) diameter (inches) 16"
- (2) total depth (feet) 102
- (3) static water level (feet) 22 below above top of ground.
- (4) casing STEEL, 62,
 (material) (depth)
16" if telescope see back.
 (size)
- (5) screen 40 62
 (length) (depth to top)
16, STEEL
 (size) (material)
- (6) pump 60 3000
 (HP) (yield gpm)
Diesel
 (type power)
- (7) electric log no
 (yes or no)
 (organization running log)
- (8) how well bottom plugged STEEL
PLATE

| description of formations encountered | from | to |
|---------------------------------------|------|-----|
| Clay | 0 | 62 |
| fine sand | 62 | 68 |
| sand & gravel | 68 | 102 |

CODED


DEPT. OF NATURAL RESOURCES
 BUREAU OF LAND & WATER RESOURCES
 AUG 26 1981
RECEIVED

AUG 1981
RECEIVED

DRILLERS REMARKS:

If well telescopes please sketch and show depths.

GROUND LEVEL

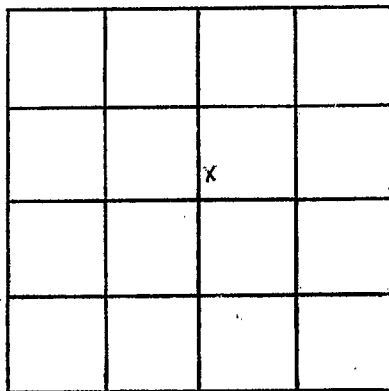

SECTION 1

Please indicate well location X.

ADDITIONAL INFORMATION

If more than one screen, show locations of each on sketch.