

SUNFLOWER
 CL-1943
 D 61
 1981

MISSISSIPPI DEPARTMENT OF NATURAL RESOURCES
 Bureau of Land and Water Resources
 Southport Mall
 P.O. Box 10631
 Jackson, Mississippi 39209
WATER WELL DRILLERS LOG

CODED

19 Layne-Central Co. firm name Sunflower county well located
 date well completed

LANDOWNER:	description of formations encountered	from	to
Wilton Hood			
Drew, MS	fine sand	18	39
(mailing address)	coarse sand	39	42
	coarse sand	42	52
	coarse sand - p.grav.	52	62
	coarse sand-p.gravel	62	72
	coarse sand-gravel	72	82
	coarse sand-gravel	82	102

WELL LOCATION:
 sec. 13 23 N R 3 E
 S W
4 miles N.E. of DREW
 (distance) (direction) (nearest town)

WELL PURPOSE: irrigation
 (home, irrigation, municipal, industrial)

- WELL COMPLETION DATA:**
- (1) diameter (inches) 20"
 - (2) total depth (feet) 101'
 - (3) static water level (feet) 30 below top of ground.
 - (4) casing PVC 61'
 (material) (depth)
8" If telescope see back.
 (size)
 - (5) screen 40' 61'
 (length) (depth to top)
8" PVC
 (size) (material)
 - (6) pump 10 840
 (HP) (yield gpm)
ECG
 (type power)
 - (7) electric log no
 (yes or no)
 (organization running log)
 - (8) how well bottom plugged plate


CODED

DEPT. OF NATURAL RESOURCES
 BUREAU OF LAND & WATER RESOURCES
 OCT 20 1981
RECEIVED

DRILLERS REMARKS:

If well telescopes please sketch and show depths.

GROUND LEVEL

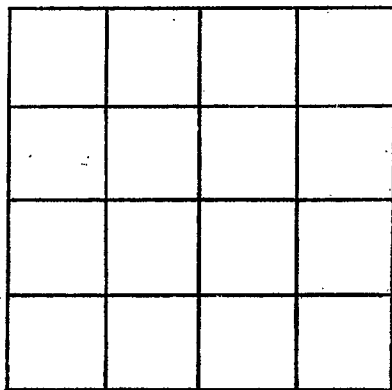

SECTION _____

Please indicate well location X.

ADDITIONAL INFORMATION

If more than one screen, show locations of each on sketch.