

MISSISSIPPI DEPARTMENT OF NATURAL RESOURCES

Bureau of Land and Water Resources

Southport Mall

P.O. Box 10631

Jackson, Mississippi 39209

WATER WELL DRILLERS LOG

CODED

SUNFLOWER
D 62
3/19/81

March 14, 1981 Lanny's well & pump Sunflower
 date well completed firm name county well located

LANDOWNER: <u>Bob Cummings</u>	description of formations encountered	from	to
<u>Drew, ms.</u> (mailing address)	<u>CLAY</u>	<u>0'</u>	<u>21'</u>
	<u>Fine SAND</u>	<u>21'</u>	<u>100'</u>
WELL LOCATION: sec <u>36</u> T <u>23</u> N R. <u>3</u> ²⁰ _W	<u>GRAVEL</u>	<u>100'</u>	<u>115'</u>
	<u>CLAY</u>	<u>115'</u>	<u>300'</u>
<u>3</u> miles <u>W</u> of <u>Drew</u> (distance) (direction) (nearest town)	<u>SAND</u>	<u>300'</u>	<u>340'</u>
	<u>CLAY</u>	<u>340'</u>	<u>460'</u>
WELL PURPOSE: (home, irrigation, municipal, industrial)	<u>SAND</u>	<u>460'</u>	<u>480'</u>
	<u>CLAY</u>	<u>480'</u>	<u>580'</u>
WELL COMPLETION DATA: (1) diameter (inches) <u>4" x 2"</u>	<u>SAND</u>	<u>580'</u>	<u>680'</u>
	(2) total depth (feet) <u>630'</u>		
(3) static water level (feet) <u>22'</u> below top of ground.			
(4) casing <u>PVC</u> <u>120'</u> or <u>4"</u> (material) (depth)			
(size) <u>480'</u> or <u>2"</u> if telescope see back.			
(5) screen <u>30'</u> <u>600'</u> (length) (depth to top)			
(size) <u>2"</u> (material) <u>PVC</u>			
(6) pump <u>#3</u> <u>2700</u> <u>50</u> (HP) (yield gpm)			
(type power) <u>Electric</u>			
(7) electric log <u>NO</u> (yes or no)			
(organization running log)			
(8) how well bottom plugged <u>SAND SHARP</u>			

CODED

DEPT. OF NATURAL RESOURCES
 BUREAU OF LAND & WATER RESOURCES


JAN 8 - 1982

RECEIVED

DRILLERS REMARKS:

If well telescopes please sketch and show depths.

GROUND LEVEL

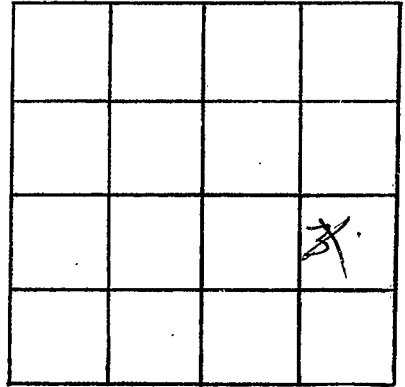

SECTION 36

Please indicate well location X.

ADDITIONAL INFORMATION

If more than one screen, show locations of each on sketch.