

MISSISSIPPI DEPARTMENT OF NATURAL RESOURCES

Bureau of Land and Water Resources

Southport Mall

P.O. Box 10631

Jackson, Mississippi 39209

WATER WELL DRILLERS LOG

CODED

BUTANE GAS CO. OF GREENWOOD

POST OFFICE BOX 2125

GREENWOOD, MISS. 38901

Sunflower
D 64
4/14/82

4-14 1982
date well completed

Sunflower
county well located

LANDOWNER:	description of formations encountered	from	to
<i>Bubba Sharden</i>	<i>sand</i>	0	50
<i>Shen Mo.</i> (mailing address)	<i>sand & gravel</i>	50	103
WELL LOCATION:			
sec. <i>29</i> T. <i>23</i> N. R. <i>3</i> W. <i>3/4</i> miles (distance) <i>N</i> (direction) of <i>Shen</i> (nearest town)			
WELL PURPOSE: <i>Irrigation</i> (home, irrigation, municipal, industrial)			
WELL COMPLETION DATA:			
(1) diameter (inches) <i>16"</i>			
(2) total depth (feet) <i>103'</i>			
(3) static water level (feet) <i>15</i> ^{below} / _{above} top of ground.			
(4) casing <i>Steel</i> , <i>63'</i> (material) (depth) <i>16"</i> If telescope see back. (size)			
(5) screen <i>40</i> , <i>63'</i> (length) (depth to top)			
<i>16"</i> , <i>steel</i> (size) (material)			
(6) pump <i>150</i> , <i>1500</i> (HP) (yield gpm)			
<i>Diesel</i> (type power)			
(7) electric log <i>NO</i> (yes or no)			
<i>NO</i> (organization running log)			
(8) how well bottom plugged <i>steel plate</i>			

DEPT. OF NATURAL RESOURCES
BUREAU OF LAND & WATER RESOURCES

MAY 10 1982


RECEIVED

DRILLERS REMARKS:

Carlos Ramos

If well telescopes please
sketch and show depths.

GROUND LEVEL

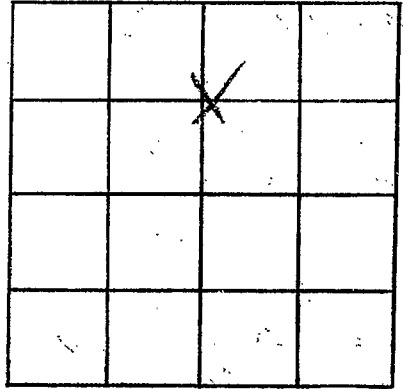

SECTION 29

Please indicate well location X.

ADDITIONAL INFORMATION

If more than one screen,
show locations of each on sketch.